

MISSISSIPPI  
BOARD OF WATER COMMISSIONERS  
416 North State Street  
Jackson, Mississippi 39201

**CODED**

**WATER WELL DRILLERS LOG**

Marion  
K 30  
2-70

FEB. 1970 E.B. SHERRARD MARION  
date well completed firm name county well located

| LANDOWNER:  | description of formations encountered | from | to   |
|---|---------------------------------------|------|------|
| BUSTER BUCHANAN   | GRAVEL                                | 0    | 5'   |
| Cts 1 - FOXWORTH, Miss.                                 | RED CLAY                              | 5'   | 80'  |
| (mailing address)                                       | RED SAND                              |      |      |
|   | SMALL TIGHT                           | 80'  | 140' |
| WELL LOCATION:  | BLUE CLAY                             | 140' | 170' |
| sec. 6 T. 3 N. R. 13 E                                  | SILT BED                              | 170' | 180' |
| 6 miles W of Columbia                                   | HARDER BLUE CLAY                      | 180' | 160' |
| (distance) (direction) (nearest town)                   | VERY COARSE SAND                      | 160' | 280' |
| WELL PURPOSE:   |                                       |      |      |
| (home) irrigation, municipal, industrial                |                                       |      |      |
| WELL COMPLETION DATA:                                   |                                       |      |      |
| (1) diameter (inches) 2"                                |                                       |      |      |
| (2) total depth (feet) 280'                             |                                       |      |      |
| (3) static water level (feet) 180' below top of ground. |                                       |      |      |
| (4) casing PL. 2.75' (material) (depth)                 |                                       |      |      |
| 2" (size) if telescope see back.                        |                                       |      |      |
| (5) screen 3' (length) (depth to top)                   |                                       |      |      |
| 2 1/2' (size) S.S. (material)                           |                                       |      |      |
| (6) pump 2 (HP) 6 (yield gpm)                           |                                       |      |      |
| E (type power)  |                                       |      |      |
| (7) electric log (yes or no)                            |                                       |      |      |
| (organization running log)                              |                                       |      |      |
| (8) how well bottom plugged BWV                         |                                       |      |      |
| DRILLERS REMARKS:                                       |                                       |      |      |


**CONFIDENTIAL**

MAR 17 1970

MISS. DD. DE  
WATER COMMI

If well telescopes please sketch and show depths.

GROUND LEVEL

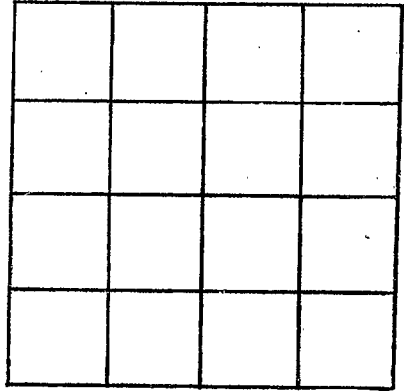

SECTION \_\_\_\_\_

Please indicate well location X.

ADDITIONAL INFORMATION

If more than one screen,  
show locations of each on sketch.