

Marion
K31
9-29-70

MISSISSIPPI
BOARD OF WATER COMMISSIONERS
416 North State Street
Jackson, Mississippi 39201

CODED

WATER WELL DRILLERS LOG

9/29 1970 Dean Greer Marion
date well completed firm name county well located

LANDOWNER:

Willie Holmet.

description of formations encountered

from to

Route 2 Fosworth, Miss.
(mailing address)

Top soil
Red clay

0-1
1-25

WELL LOCATION:

sec 20 T 3 N R 13 E
S W
5 miles S W Fosworth
(distance) (direction) (nearest town)

Red sand
Chalk
Gravel

25-65
65-90
90-125

WELL PURPOSE: Home Use
(home, irrigation, municipal, industrial)

Chalk

125-170

WELL COMPLETION DATA:

- (1) diameter (inches) 4"
- (2) total depth (feet) 260
- (3) static water level (feet) _____ below above top of ground.
- (4) casing Plastic, 250'
(material) (depth)
- _____ if telescope see back.
(size)
- (5) screen 10' , 250'
(length) (depth to top)
- 4" , Plastic
(size) (material)
- (6) pump 1/2 HP, _____
(HP) (yield gpm)
- F.B.M. sub pump
(type power)
- (7) electric log No
(yes or no)

red sand
fine sand
Coke water sand

170-185
185-225
225-260

(organization running log)

(8) how well bottom plugged _____


MAR 18 1970

MISS. BD. OF
WATER COMM.

DRILLERS REMARKS:

If well telescopes please sketch and show depths.

GROUND LEVEL

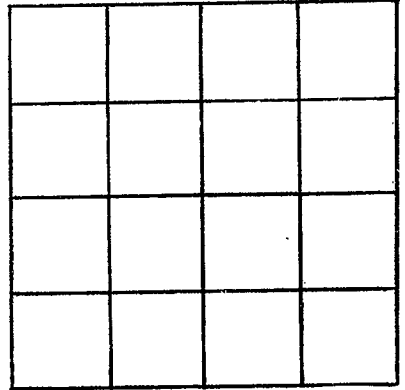

SECTION _____

Please indicate well location X.

ADDITIONAL INFORMATION

If more than one screen, show locations of each on sketch.