

MARION
K 32
7-70

MISSISSIPPI
BOARD OF WATER COMMISSIONERS
416 North State Street
Jackson, Mississippi 39201

CODED

WATER WELL DRILLERS LOG

July 1970 E.B. SHERRARD MARION
date well completed firm name county well located

LANDOWNER: RICKY COX
Box 71 - Foxworth, Miss
(mailing address)

description of formations encountered from to
GRAVEL & SAND @ 124

WELL LOCATION:
sec 23 T 3 N R 19 E
2 miles S of Foxworth
(distance) (direction) (nearest town)

WELL PURPOSE:
(home, irrigation, municipal, industrial)

CODED

- WELL COMPLETION DATA:
- (1) diameter (inches) 2"
 - (2) total depth (feet) 124
 - (3) static water level (feet) 58 below above top of ground.
 - (4) casing PLASTIC, 119 (material) (depth)
2" (size) if telescope see back.
 - (5) screen 3' (length) (depth to top)
2" (size) 3x5 (material)
 - (6) pump 3/4 (HP) 7 (yield gpm)
E (type power)
 - (7) electric log (yes or no) (no)
 - (organization running log)
 - (8) how well bottom plugged BWV


AUG 13 1970

DRILLERS REMARKS:

MISS. BD. OF
WATER COMMISSIONERS

If well telescopes please sketch and show depths.

GROUND LEVEL

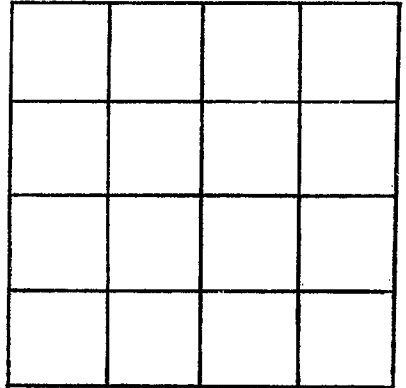

SECTION _____

Please indicate well location X.

ADDITIONAL INFORMATION

If more than one screen, show locations of each on sketch.