

MARION
K33
9-70

MISSISSIPPI
BOARD OF WATER COMMISSIONERS
416 North State Street
Jackson, Mississippi 39201

CODED

WATER WELL DRILLERS LOG

SEPT. 1970 E.B. SHERRARD MARION
date well completed firm name county well located

LANDOWNER:
GEORGE SMITH
FOXWORTH, MISS.
(mailing address)

description of formations encountered from to
LOOSE SAND
+ GRAVEL 0 260

WELL LOCATION:
sec 29 T. 30 N R. 19 E
4 miles SW of FOXWORTH
(distance) (direction) (nearest town)

WELL PURPOSE:
(home) irrigation, municipal, industrial

- WELL COMPLETION DATA:
- (1) diameter (inches) 4"
 - (2) total depth (feet) 260
 - (3) static water level (feet) 210 below above top of ground.
 - (4) casing PL, 250, (material) (depth), 4" (size) if telescope see back.
 - (5) screen 10' (length), (depth to top) 4" (size), PLASTIC (material)
 - (6) pump 1 SUB. 20 (HP) (yield gpm) E (type power)
 - (7) electric log (yes or no)
 - (organization running log)
 - (8) how well bottom plugged BWV

CODED


OCT 19 1970

MISS. BD. OF WATER

DRILLERS REMARKS:

If well telescopes please sketch and show depths.

GROUND LEVEL

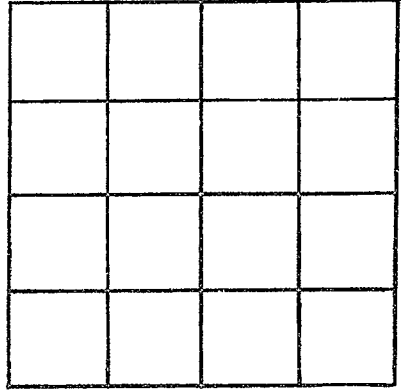

SECTION _____

Please indicate well location X.

ADDITIONAL INFORMATION

If more than one screen, show locations of each on sketch.