

Marion
K 34
11-10-69

MISSISSIPPI
BOARD OF WATER COMMISSIONERS
416 North State Street
Jackson, Mississippi 39201

Rev 4/17/70
led 11/30/70
CODED

WATER WELL DRILLERS LOG

11/10 date well completed 1969 Dean Kriner firm name Marion county well located

LANDOWNER:

Red Thompson
Route 1, Foxworth, Miss.
(mailing address)

| description of formations encountered | from | to |
|---------------------------------------|------|-----|
| Top soil | 0 | 1 |
| Red Clay | 1 | 30 |
| Red sand | 30 | 45 |
| gravel | 45 | 65 |
| Chalk | 65 | 85 |
| gravel | 85 | 105 |
| Chalk | 105 | 130 |
| fine white sand | 130 | 155 |
| Coarse water sand | 155 | 185 |

WELL LOCATION:

sec. 7 T 30 N R 19 E
S W of Foxworth
(distance) (direction) (nearest town)

WELL PURPOSE: Home Use
(home, irrigation, municipal, industrial)

WELL COMPLETION DATA:

- (1) diameter (inches) 4"
- (2) total depth (feet) 185'
- (3) static water level (feet) 105' below top of ground
- (4) casing Plastic, 175' (material) (depth)
- (size) If telescope see back.
- (5) screen 10' length, 175' depth to top
4" Plastic (size) (material)
- (6) pump Used old pump (HP) (yield gpm)
(type power)
- (7) electric log No (yes or no)
- (organization running log)
- (8) how well bottom plugged

CODED


MAR 18 1970

MISS. Bd. of
WATER COMM.

DRILLERS REMARKS:

If well telescopes please sketch and show depths.

GROUND LEVEL

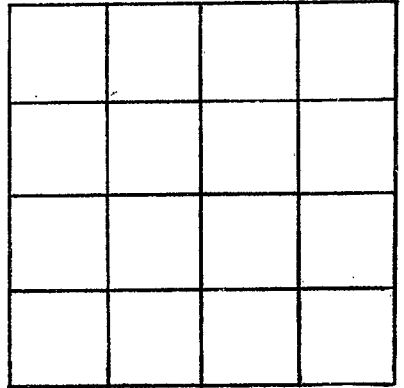

SECTION _____

Please indicate well location X.

ADDITIONAL INFORMATION

If more than one screen, show locations of each on sketch.