

MARION
K 35
5-14-71

MISSISSIPPI
BOARD OF WATER COMMISSIONERS
416 North State Street
Jackson, Mississippi 39201

CODED

WATER WELL DRILLERS LOG

5-14-71 date well completed
Dun Shines Drilling Co. firm name
Marion county well located

LANDOWNER: Cat
Cat's News
Route 1, Foxworth Miss
(mailing address)

description of formations encountered	from	to
top soil	0	1
red clay	1	12'
sand & gravel	12	44'
water sand	44	84

WELL LOCATION:
sec 15 T 3 N R 12 E
1 miles S of Foxworth
(distance) (direction) (nearest town)

WELL PURPOSE: Home Use
(home, irrigation, municipal, industrial)

- WELL COMPLETION DATA:
- (1) diameter (inches) 2"
 - (2) total depth (feet) 84
 - (3) static water level (feet) 42 below above top of ground.
 - (4) casing plastic, 75'
(material) (depth)
____ (size) if telescope see back.
 - (5) screen 7', 77'
(length) (depth to top)
2", plastic
(size) (material)
 - (6) pump 1/2 (HP) _____ (yield gpm)
____ (type power)
 - (7) electric log _____ (yes or no)
____ (organization running log)
 - (8) how well bottom plugged _____

CODED


MAY 19 1971

DRILLERS REMARKS:

MISSISSIPPI
BOARD OF WATER COMMISSIONERS
JACKSON, MISSISSIPPI

If well telescopes please
etch and show depths.

GROUND LEVEL

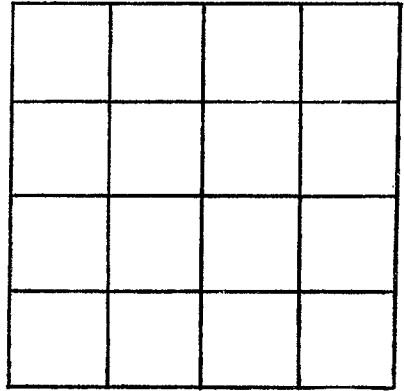

SECTION _____

Please indicate well location X.

ADDITIONAL INFORMATION

If more than one screen,
show locations of each on sketch.