

MISSISSIPPI
BOARD OF WATER COMMISSIONERS
416 North State Street
Jackson, Mississippi 39201

CODED

WATER WELL DRILLERS LOG

MARION
K 36
1-71

JAN 1970 E. B. SHERRARD MARION
date well completed firm name county well located

LANDOWNER:

JACKIE STRINGER

description of formations encountered

from to

Rt. 1 - FOXWORTH
(mailing address)

RED SANDY
CLAY & FINE
STREAKS RED
CLAY

0 180

WELL LOCATION:

sec. 31 T. 3 N. R. 13 E.
7 1/2 miles SW of Columbia
(distance) (direction) (nearest town)

FINE TIGHT
SAND - BLUE &
GRAY STREAKS
CLAY

180 240

WELL PURPOSE:

(home) irrigation, municipal, industrial

GOOD FINE GRAVEL
& VERY COARSE
SAND

240 256

WELL COMPLETION DATA:

- (1) diameter (inches) 4"
- (2) total depth (feet) 256'
- (3) static water level (feet) 180' ^{below} top of ground.
- (4) casing PL. 246' (material) (depth)
4" (size) If telescope see back.
- (5) screen 10' (length) (depth to top)
4" (size) PL. (material)
- (6) pump 1/2 SUB. 24 (HP) (yield gpm)
E (type power)
- (7) electric log (yes or no)

CODED

(organization running log)

FEB 1 1971


(8) how well bottom plugged BWP

MISS. BD. OF
WATER COMM.

DRILLERS REMARKS:

If well telescopes please sketch and show depths.

GROUND LEVEL

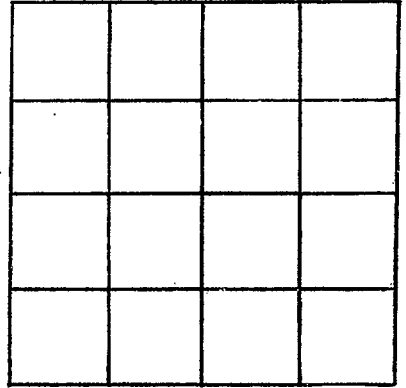

SECTION _____

Please indicate well location X.

ADDITIONAL INFORMATION

If more than one screen,
show locations of each on sketch.