

MARION  
K37  
1-71

MISSISSIPPI  
BOARD OF WATER COMMISSIONERS  
416 North State Street  
Jackson, Mississippi 39201

**CODED**

WATER WELL DRILLERS LOG

JAN. 1971 E.B. SHERKARD MARION  
date well completed firm name county well located

LANDOWNER:  
JIMMIE DALE ALFORD  
FOXWORTH, Miss.  
(mailing address)

description of formations encountered	from	to
REDDISH SANDY CLAY	0	30'
GRAVEL & SAND	30	57'
BLUE CLAY AND HARD	57'	190'
FINE GRAY SAND	190'	220'
COARSE SAND WITH LITTLE PEA GR.	220'	237'

WELL LOCATION:  
sec. 22 T. 3 N. R. 13 E. S. 13  
1 miles SW of FOXWORTH  
(distance) (direction) (nearest town)

WELL PURPOSE:  
 (home) Irrigation, municipal, industrial

WELL COMPLETION DATA:

- (1) diameter (inches) 2"
- (2) total depth (feet) 237'
- (3) static water level (feet) 90  below  above top of ground.
- (4) casing PL. 230,  
(material) (depth)  
2"  
(size) if telescope see back.
- (5) screen 5',  
(length) (depth to top)  
2", PL.  
(size) (material)
- (6) pump 1 1/2 8  
(HP) (yield gpm)  
E  
(type power)
- (7) electric log (yes or no)  
(organization running log)
- (8) how well bottom plugged BWV

**CODED**


FEB 1 1971

DRILLERS REMARKS:

MISS. BD. OF  
WATER COMM.

If well telescopes please sketch and show depths.

GROUND LEVEL

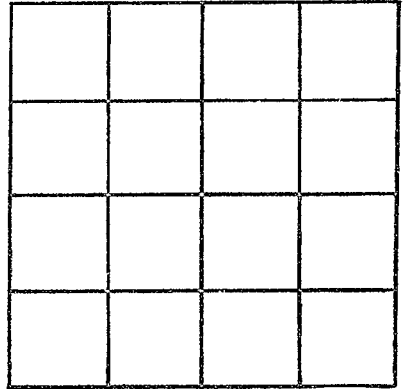

SECTION \_\_\_\_\_

Please indicate well location X.

ADDITIONAL INFORMATION

If more than one screen, show locations of each on sketch.