

MARION
K 38
3-71

MISSISSIPPI
BOARD OF WATER COMMISSIONERS
416 North State Street
Jackson, Mississippi 39201

CODED

WATER WELL DRILLERS LOG

MARCH 1971 E.B. SHEPARD MARION
date well completed firm name county well located

LANDOWNER:
REV. LIZ. BLANKENSHIP
Rt. 1 Foxworth, Miss
(mailing address)

WELL LOCATION:
sec. 17 T. 3 N R. 19 E
S W
2 miles W of Foxworth
(distance) (direction) (nearest town)

WELL PURPOSE:
(Home) Irrigation, municipal, industrial

- WELL COMPLETION DATA:
- (1) diameter (inches) 3"
 - (2) total depth (feet) 158
 - (3) static water level (feet) 105 ^{below} top of ground
 - (4) casing PL. 152, (material) (depth)
3" (size) if telescope see back.
 - (5) screen 6' (length) (depth to top)
3" (size) PL. (material)
 - (6) pump 1/2 (HP) 8 (yield gpm)
E (type power)
 - (7) electric log (yes or no)
 - (organization running log)
 - (8) how well bottom plugged B.W.V

description of formations encountered	from	to
SAND + SANDY		
RED CLAY		
MIXED	0	80
LOOSE GRAVEL	80	130
TIGHT PACKED		
FINE GRAVEL		
COARSE SAND	130	158
BLUE CLAY BOTTOM		

CODED


MAY 27 1971

MISS. BD. OF
WATER COMM.

DRILLERS REMARKS:

If well telescopes please sketch and show depths.

GROUND LEVEL

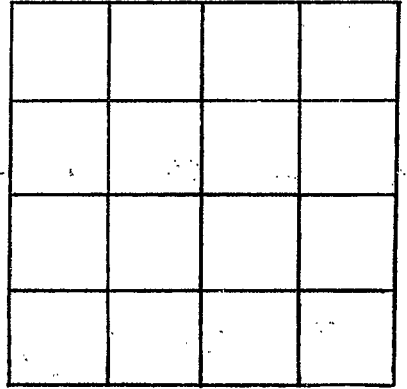

SECTION _____

Please indicate well location X.

ADDITIONAL INFORMATION

More than one screen,
locations of each on sketch.