

MARION
K41
6-10-71

MISSISSIPPI
BOARD OF WATER COMMISSIONERS
416 North State Street
Jackson, Mississippi 39201

CODED

WATER WELL DRILLERS LOG

6-10-71 date well completed
Dean Siverdilling Co. firm name
Marion county well located

| LANDOWNER: | description of formations encountered | from | to |
|--|---------------------------------------|------|-----|
| Charles Pittman | Top soil | 0 | 1' |
| Route 1, Foxworth, Miss. (mailing address) | Red clay | 1 | 5' |
| WELL LOCATION: sec. 7 T. 3 N. R. 13 E. 5 miles west of Foxworth (distance) (direction) (nearest town) | gravel | 5 | 20 |
| WELL PURPOSE: <u>Private</u> (home, irrigation, municipal, industrial) | Chalk | 20 | 35 |
| WELL COMPLETION DATA: | Sand & gravel | 35 | 70 |
| (1) diameter (inches) <u>4"</u> | Water sand | 70 | 132 |
| (2) total depth (feet) <u>132'</u> | | | |
| (3) static water level (feet) <u>70'</u> below top of ground. | | | |
| (4) casing <u>plastic</u> , <u>122'</u> (depth) | | | |
| (size) if telescope see back. | | | |
| (5) screen <u>10'</u> , <u>122'</u> (length) (depth to top) | | | |
| <u>4"</u> , <u>Plastic</u> (size) (material) | | | |
| (6) pump <u>1</u> (HP) (yield gpm) | | | |
| (type power) | | | |
| (7) electric log (yes or no) | | | |
| (organization running log) | | | |
| (8) how well bottom plugged | | | |
| DRILLERS REMARKS: | | | |


CODED

JUL 6 1971

MISS. RD. & WATER COM.

If well telescopes please sketch and show depths.

GROUND LEVEL

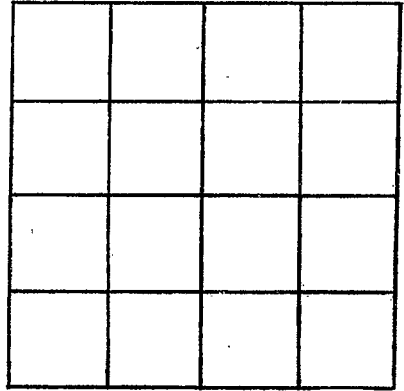

SECTION _____

Please indicate well location X.

ADDITIONAL INFORMATION

If more than one screen,
show locations of each on sketch.