

Marion  
 K-42  
 7-71

MISSISSIPPI  
 BOARD OF WATER COMMISSIONERS  
 416 North State Street  
 Jackson, Mississippi 39201

WATER WELL DRILLERS LOG

**CODED**

July 1971 E.B. SHEPPARD  
 date well completed firm name county well located

LANDOWNER:  
 OTTIS LEWIS  
 FOXWORTH  
 (mailing address)

description of formations encountered from to  
 SAND & GRAVEL 0 62'

WELL LOCATION:  
 sec. 15 T. 3 N. R. 19 E.  
 S W  
 1/2 miles W of FOXWORTH  
 (distance) (direction) (nearest town)

WELL PURPOSE:  
 (Home, Irrigation, municipal, industrial)

- WELL COMPLETION DATA:
- (1) diameter (inches) 2"
  - (2) total depth (feet) 62
  - (3) static water level (feet) 32 below above top of ground.
  - (4) casing PL 57 (material) (depth)  
2' if telescope see back. (size)
  - (5) screen 5' (length) (depth to top)  
2" PL (size) (material)
  - (6) pump 1/2 7 (HP) (yield gpm)  
E (type power)
  - (7) electric log (yes or no)
  - (organization running log)
  - (8) how well bottom plugged B.W.V

**CODED**


SEP 15 1971

DRILLERS REMARKS:

MISS. BD. OF WATER COMM.

If well telescopes please sketch and show depths.

GROUND LEVEL

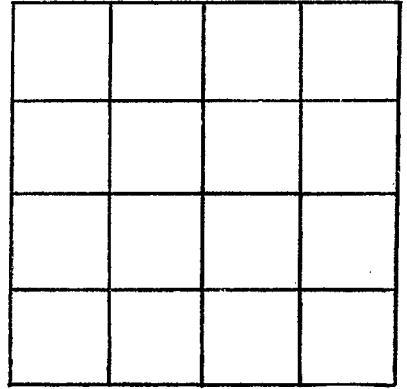

SECTION \_\_\_\_\_

Please indicate well location X.

ADDITIONAL INFORMATION

If more than one screen,  
show locations of each on sketch.