

MARION
K 43
10-8-71

MISSISSIPPI
BOARD OF WATER COMMISSIONERS
416 North State Street
Jackson, Mississippi 39201

FEB - 7 1972

WATER WELL DRILLERS LOG

CODED

10-8 1971 *Dean Briss Well Drilling* firm name
date well completed county well located

LANDOWNER:
Church Property
Route 1, Foxworth, Miss
(mailing address)

description of formations encountered	from	to
<i>top soil</i>	0	1'
<i>gravel</i>	1'	15'
<i>Chalk</i>	15'	27'
<i>sand & gravel</i>	27'	28'
<i>fine sand</i>	28'	50'
<i>Water sand</i>	50'	62'

WELL LOCATION:
sec. 18 T 3 N. R. 13 E
S W
8 miles W of Columb
(distance) (direction) (nearest town)

WELL PURPOSE: *Church*
(home, irrigation, municipal, industrial)


- WELL COMPLETION DATA:
- (1) diameter (inches) 2"
 - (2) total depth (feet) 62'
 - (3) static water level (feet) 15' below top of ground.
 - (4) casing Plastic, 59'
(material) (depth)
If telescope see back.
(size)
 - (5) screen 4', 59'
(length) (depth to top)
2", S.S.
(size) (material)
 - (6) pump _____ (HP) _____ (yield gpm)
(type power)
 - (7) electric log _____ (yes or no)
(organization running log)
 - (8) how well bottom plugged _____

CODED

DRILLERS REMARKS:

If well telescopes please sketch and show depths.

GROUND LEVEL

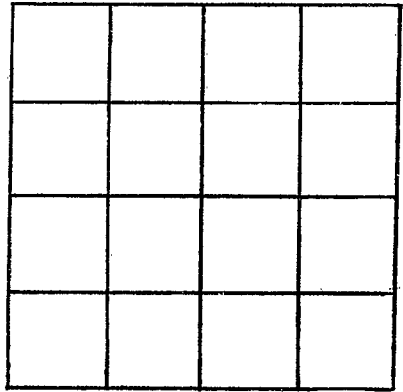

SECTION _____

Please indicate well location X.

ADDITIONAL INFORMATION

If more than one screen, show locations of each on sketch.