

MARION  
K 45  
11-4-71

MISSISSIPPI  
BOARD OF WATER COMMISSIONERS  
416 North State Street  
Jackson, Mississippi 39201

FEB - 7 1972

CODED

WATER WELL DRILLERS LOG

NOV 4 1971 date well completed  
71 Chester Belser firm name  
Marion county well located

LANDOWNER: James Thompson  
Columbia

description of formations encountered	from	to
Red Sandy clay	0	35
Red sand	35	117
pink chalk	117	130
Red gravel sand	130	138
Red sand	138	202
Coarse sand	202	240

(mailing address)

WELL LOCATION: 13 E  
sec. 20 T 3 N R. 10 E  
2 1/4 miles WSW Falmouth  
(distance) (direction) (nearest town)

WELL PURPOSE: Home  
(home, irrigation, municipal, industrial)

WELL COMPLETION DATA:

- (1) diameter (inches) 4 1/4
- (2) total depth (feet) 240
- (3) static water level (feet) 170 below top of ground
- (4) casing (material) Plast, (depth) Bottom
- (size) if telescope see back.
- (5) screen 6' 2 3/4' (length) (depth to top)
- 4" Plast (size) (material)
- (6) pump 3/4 HP 10 (HP) (yield gpm)
- Elect (type power)
- (7) electric log No (yes or no)

(organization running log)


(8) how well bottom plugged  
wooden plug

DRILLERS REMARKS:  
New house

CODED

If well telescopes please sketch and show depths.

GROUND LEVEL

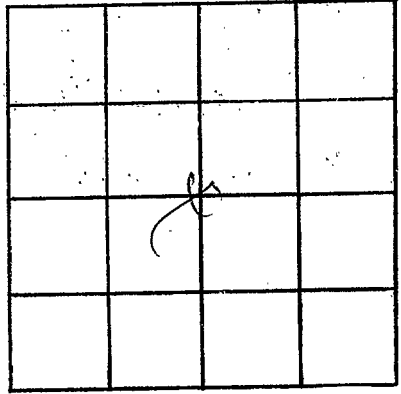

SECTION 20

Please indicate well location X.

ADDITIONAL INFORMATION

If more than one screen, show locations of each on sketch.