

MARION
K46
4-28-72

MISSISSIPPI
BOARD OF WATER COMMISSIONERS
416 North State Street
Jackson, Mississippi 39201

WATER WELL DRILLERS LOG

CODED

4-28 1972 Priner Water Well Drilling Marion
date well completed firm name county well located

LANDOWNER:

7 Mrs. Ralphy Link
1314 Ch. St. Columbia, Miss.
(mailing address)

description of formations encountered

from to

Top Soil	0	1'
clay	1	5'
gravel	5	9'
water sand	9	25'

WELL LOCATION:

sec. 12 T. 3 N. R. 13 E.
1 miles W of Columbia
(distance) (direction) (nearest town)

WELL PURPOSE: Home
(home, irrigation, municipal, industrial)

WELL COMPLETION DATA:

- (1) diameter (inches) 4"
- (2) total depth (feet) 25'
- (3) static water level (feet) 1' below above top of ground.
- (4) casing Plastic 15'
(material) (depth)
4" if telescope see back.
(size)
- (5) screen 10' 15'
(length) (depth to top)
4" Plastic
(size) (material)
- (6) pump 1/4 60
(HP) (yield gpm)
electric
(type power)
- (7) electric log _____
(yes or no)

(organization running log)
- (8) how well bottom plugged _____

CODED


CO

JUL 19 1972

DRILLERS REMARKS:

If well telescopes please
sketch and show depths.

GROUND LEVEL

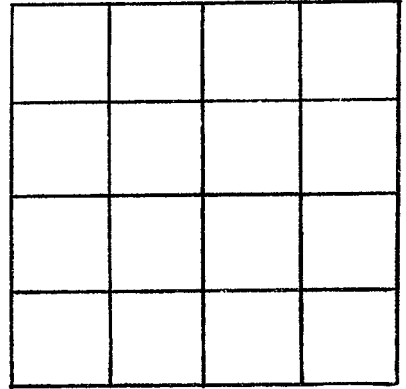

SECTION _____

Please indicate well location X.

ADDITIONAL INFORMATION

If more than one screen,
show locations of each on sketch.