

MARION
K49
12-72

MISSISSIPPI
BOARD OF WATER COMMISSIONERS
416 North State Street
Jackson, Mississippi 39201

CODED

WATER WELL DRILLERS LOG

DEC 1972 E. B. Sheppard Marion
date well completed firm name county well located

LANDOWNER: Laman Scarborough
P.O. 1 Forworth
(mailing address)

description of formations encountered SAND & GRAVEL from 0 to 35

WELL LOCATION:

sec 3 T 3 N R 13 E
S W
1 miles N Forworth
(distance) (direction) (nearest town)

WELL PURPOSE:

(home) irrigation, municipal, industrial

WELL COMPLETION DATA:

- (1) diameter (inches) 2"
- (2) total depth (feet) 35'
- (3) static water level (feet) _____ below/above top of ground.
- (4) casing (material) pl. (depth) 30'
2" (size) if telescope see back.
- (5) screen (length) 5' (depth to top) _____
2" (size) pl. (material)
- (6) pump (HP) _____ (yield gpm) _____
E (type power)
- (7) electric log (yes or no) _____
(organization running log) _____
- (8) how well bottom plugged BWV


CODED

DRILLERS REMARKS:

MISSISSIPPI BOARD OF WATER COMMISSIONERS
416 NORTH STATE STREET
JACKSON, MISSISSIPPI 39201

If well telescopes please sketch and show depths.

GROUND LEVEL

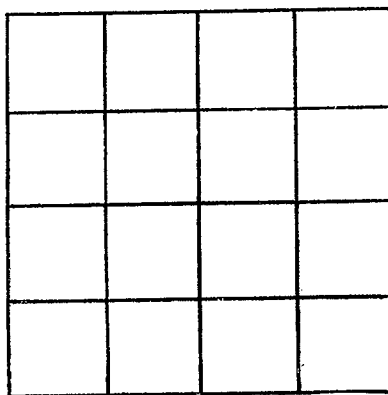

SECTION _____

Please indicate well location X.

ADDITIONAL INFORMATION

If more than one screen,
show locations of each on sketch.