

MARION
K 50
2-15-72

MISSISSIPPI
BOARD OF WATER COMMISSIONERS
416 North State Street
Jackson, Mississippi 39201

CODED

WATER WELL DRILLERS LOG

Feb. 15 1972 Dean Green Water Well Drilling Marion
date well completed firm name county well located

LANDOWNER: Larry Terrell
Rt 2 Foxworth

(mailing address)

WELL LOCATION:

sec. 21 T. 3 N R. 13 E
2 miles W of Foxworth
(distance) (direction) (nearest town)

WELL PURPOSE: home
(home, irrigation, municipal, industrial)

WELL COMPLETION DATA:

- (1) diameter (inches) 2"
- (2) total depth (feet) 82'
- (3) static water level (feet) — below above top of ground.
- (4) casing Plastic, 73' (material) (depth)
2" (size) if telescope see back.
- (5) screen 7' 75' (length) (depth to top)
2" Plastic (size) (material)
- (6) pump 1 (HP) 45 (yield gpm)
electric (type power)
- (7) electric log (yes or no)
- (organization running log)
- (8) how well bottom plugged

description of formations encountered

from

to

top Soil

0 1'

gravel

1 13

clay

13 28'

gravel

28 56'

chalk

56 63'

sand

63 70'

water sand

70 82'

CODED


DRILLERS REMARKS:

JUN 19 1972

MISSISSIPPI BOARD OF WATER COMMISSIONERS

If well telescopes please
sketch and show depths.

GROUND LEVEL

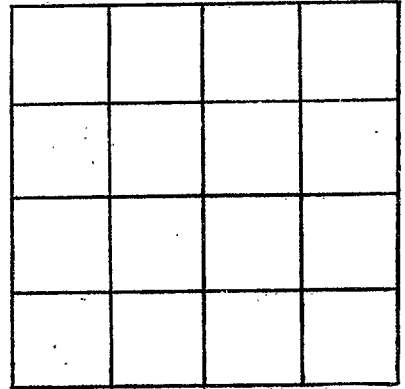

SECTION _____

Please indicate well location X.

ADDITIONAL INFORMATION

If more than one screen,
show locations of each on sketch.