

MARION
K51
2-7-72

MISSISSIPPI
BOARD OF WATER COMMISSIONERS
416 North State Street
Jackson, Mississippi 39201

WATER WELL DRILLERS LOG

Feb. 7 1972 Dean Griner Water Well Drilling Marion
date well completed firm name county well located

LANDOWNER:
Wallace Louis
Rt 1 Foxworth Miss
(mailing address)

WELL LOCATION:
sec. 21 T. 3 N. R. 13 E
2 miles W of Foxworth
(distance) (direction) (nearest town)

WELL PURPOSE: home
(home, irrigation, municipal, industrial)

- WELL COMPLETION DATA:
- (1) diameter (inches) 2"
 - (2) total depth (feet) 196'
 - (3) static water level (feet) below top of ground
 - (4) casing (material) 190' (depth)
2" (size) if telescope see back.
 - (5) screen 4' 192' (length) (depth to top)
2" (size) Stainless Steel (material)
 - (6) pump 2 40 (HP) (yield gpm)
electric (type power)
 - (7) electric log (yes or no)
 - (organization running log)
 - (8) how well bottom plugged

description of formations encountered	from	to
top soil	0	1'
gravel	1	28'
chalk	28	63'
gravel	63	109'
sand	109	135'
gravel	135	178'
water sand	178	196'

CODED

CODED


JUL 10 1972

DRILLERS REMARKS:

MISS. B. WATER COM.

If well telescopes please sketch and show depths.

GROUND LEVEL

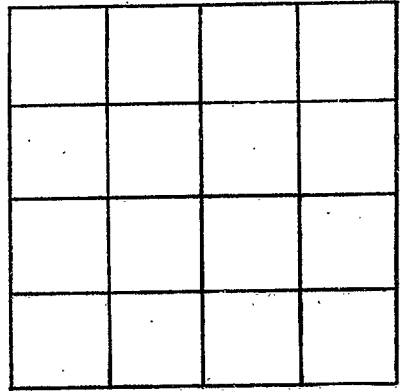

SECTION _____

Please indicate well location X.

ADDITIONAL INFORMATION

If more than one screen,
show locations of each on sketch.