

MARION  
K53  
6-73

MISSISSIPPI  
BOARD OF WATER COMMISSIONERS  
416 North State Street  
Jackson, Mississippi 39201

CODED

WATER WELL DRILLERS LOG

June 1973 E.B. Sheppard Marion  
date well completed firm name county well located

LANDOWNER:

Walter Willis  
Tupac  
(mailing address)

description of formations encountered

VERY LOOSE  
MID SANDY  
GR. & CLAY @ 160'  
SMALL PEA GR +  
COARSE SAND 160' 180'

from to

WELL LOCATION:

sec 20 T 30 S R 13E  
2 1/2 miles WSW Tupac  
(distance) (direction) (nearest town)

WELL PURPOSE:

(home, irrigation, municipal, industrial)

WELL COMPLETION DATA:

- (1) diameter (inches) 2"  
(2) total depth (feet) 180'  
(3) static water level (feet) 120' below above top of ground.  
(4) casing pl. 175'  
(size) (material) (depth)  
2" if telescope see back.  
(size)  
(5) screen 5'  
(length) (depth to top)  
2" pl.  
(size) (material)  
(6) pump 1 1/2 6  
(HP) (yield gpm)  
E  
(type power)  
(7) electric log (yes or no)

CODED

(organization running log)

(8) how well bottom plugged BWV


OCT 10 1973

DRILLERS REMARKS:

MISS. BD. OF  
WATER COMM

If well telescopes please  
sketch and show depths.

GROUND LEVEL

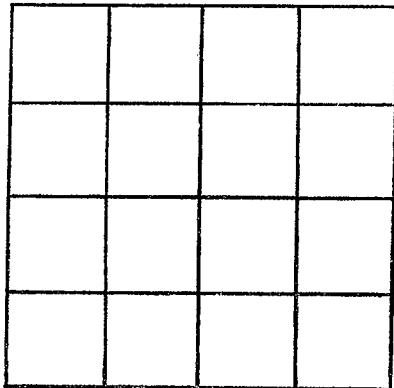

SECTION \_\_\_\_\_

Please indicate well location X.

ADDITIONAL INFORMATION

If more than one screen,  
show locations of each on sketch.