

MARION  
K54  
8-26-73

MISSISSIPPI  
BOARD OF WATER COMMISSIONERS  
416 North State Street  
Jackson, Mississippi 39201

CODED  
for info  
Oct 11-73

WATER WELL DRILLERS LOG

8/26 1973 Grimes-Gunn Marion  
date well completed firm name county well located

LANDOWNER: Pauline Jordan

description of formations encountered from to

Rt #2,  
Roxworth, Miss  
(mailing address)

Top Soil 0 1  
Clay 1 38  
Gravel 38 106  
Sand Gravel 106 163

WELL LOCATION:  
sec. 23 T 3 N R 13 E  
2 miles S of Grimes-Gunn  
(distance) (direction) (nearest town)

WELL PURPOSE: Home  
(home, irrigation, municipal, industrial)

- WELL COMPLETION DATA:
- (1) diameter (inches) 2"
  - (2) total depth (feet) 163
  - (3) static water level (feet) 95' below above top of ground
  - (4) casing Plastic, 153'  
(material) (depth)  
2" if telescope see back.  
(size)
  - (5) screen 10 ft, 153'  
(length) (depth to top)  
2", Plastic  
(size) (material)
  - (6) pump 1/2 6  
(HP) (yield gpm)  
E. loc  
(type power)
  - (7) electric log no  
(yes or no)

CODED

(organization running log)


(8) how well bottom plugged  
B W Valve

DRILLERS REMARKS:

OCT 9 1973

If well telescopes please sketch and show depths.

GROUND LEVEL

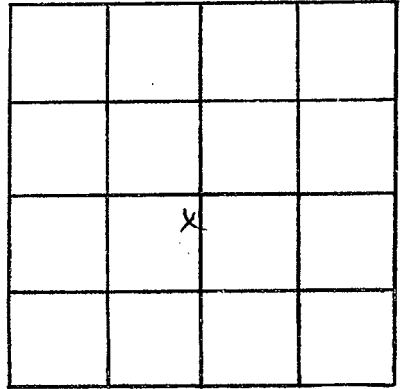

SECTION 23

Please indicate well location X.

ADDITIONAL INFORMATION

If more than one screen,  
show locations of each on sketch.