

MARION
K 56
8/73

MISSISSIPPI
BOARD OF WATER COMMISSIONERS
416 North State Street
Jackson, Mississippi 39201

CODED

WATER WELL DRILLERS LOG

Aug. 1973 E. B. Sheppard Marion
date well completed firm name county well located

LANDOWNER:
Pearce McKenzie
Rt. 1 Forworth Ms.
(mailing address)

description of formations encountered	from	to
SAND -	0	25
GRAVEL + SAND	25	68'

WELL LOCATION:
sec. 35 T 3 N R 13 E
S W
3 miles S Forworth
(distance) (direction) (nearest town)

WELL PURPOSE:
(home irrigation, municipal, industrial)

- WELL COMPLETION DATA:
- (1) diameter (inches) 2"
 - (2) total depth (feet) 68'
 - (3) static water level (feet) 24' below top of ground.
 - (4) casing (material) pl. (depth) 63'
2" if telescope see back. (size)
 - (5) screen (length) 5' (depth to top) 5'
2" (size) pl. (material)
 - (6) pump (HP) 1/2 (yield gpm) 7
E (type power)
 - (7) electric log (yes or no) (no)
 - (8) how well bottom plugged BWD

DRILLERS REMARKS:

CODED


1974

FED

MISS. BOARD OF WATER COMMISSIONERS

If well telescopes please sketch and show depths.

GROUND LEVEL

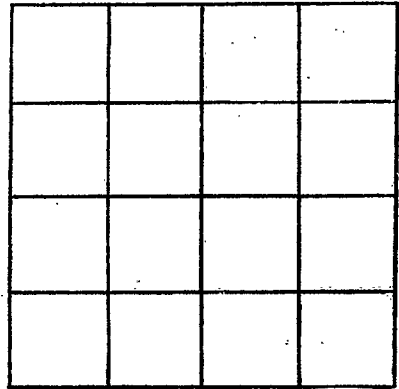

SECTION _____

Please indicate well location X.

ADDITIONAL INFORMATION

If more than one screen, show locations of each on sketch.