

MISSISSIPPI
BOARD OF WATER COMMISSIONERS
416 North State Street
Jackson, Mississippi 39201

WATER WELL DRILLERS LOG

MARION
K 58
5-23-72

May 23, 1972 date well completed
Chester Keenan firm name
Marion county well located

LANDOWNER: Jur Sales
RFD-Foxworth

(mailing address)

WELL LOCATION:

sec. 7 T. 3 N. R. 13 E.
4 miles WNW of Foxworth
(distance) (direction) (nearest town)

WELL PURPOSE: same
(home, irrigation, municipal, industrial)

WELL COMPLETION DATA:

- (1) diameter (inches) 4"
(2) total depth (feet) 160
(3) static water level (feet) 21 below above top of ground
(4) casing Plast Ballam
(material) (depth)
if telescope see back.
(size)
(5) screen 6' 154
(length) (depth to top)
4" Plast
(size) (material)
(6) pump 1/2 sub 12
(HP) (yield gpm)
Electric
(type power)
(7) electric log NO
(yes or no)

(organization running log)

(8) how well bottom dugged

wooden plug

DRILLERS REMARKS:

old 2" well bad

description of formations encountered	from	to
Red clay & gravel	0	24
Red sand	24	47
Red chalk	47	83
fine red sand	83	140
Red gravel & sand	140	160


COPIED

NOV 23 1972

DRILLER'S NAME

If well telescopes please sketch and show depths.

GROUND LEVEL

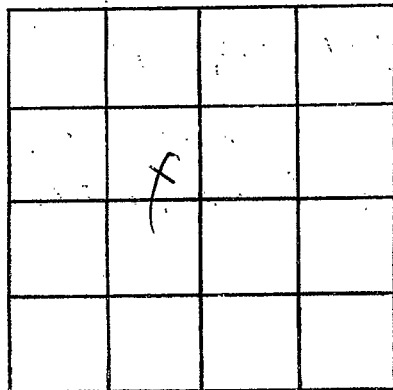

SECTION 7

Please indicate well location X.

ADDITIONAL INFORMATION

If more than one screen,
show locations of each on sketch.