

MARION  
 IC 60  
 S-9-73

MISSISSIPPI  
 BOARD OF WATER COMMISSIONERS  
 416 North State Street  
 Jackson, Mississippi 39201

CODED

WATER WELL DRILLERS LOG

May 9 1973 Chestnut Hill Marion  
 date well completed firm name county well located

LANDOWNER: Clayton Smith Foxworth  
 (mailing address)

WELL LOCATION:  
 sec. 20 T. 3 N. R. 13 E  
2 1/2 miles SE Foxworth  
 (distance) (direction) (nearest town)

WELL PURPOSE: Home  
 (home, irrigation, municipal, industrial)

- WELL COMPLETION DATA:
- (1) diameter (inches) 4"
  - (2) total depth (feet) 222
  - (3) static water level (feet) 152 below top of ground
  - (4) casing Plast. Galv. (material) Bottom (depth)
  - \_\_\_\_\_ If telescope see back. (size)
  - (5) screen 6' 2 1/2' (length) (depth to top)
  - 4" Plast (size) (material)
  - (6) pump 3/4 Sub 12 (HP) 12 (yield gpm)
  - Elect (type power)
  - (7) electric log NO (yes or no)
  - \_\_\_\_\_ (organization running log)
  - (8) how well bottom plugged wooden plug

description of formations encountered	from	to
Red Clay	0	17
Sand & gravel	17	44
white chalk	44	68
Sand	68	127
Sand & gravel	127	138
fine sand	138	205
Coarse sand	205	222


CODED

RECORDED  
 MAY 24 1973

DRILLERS REMARKS:  
New house

If well telescopes please sketch and show depths.

GROUND LEVEL

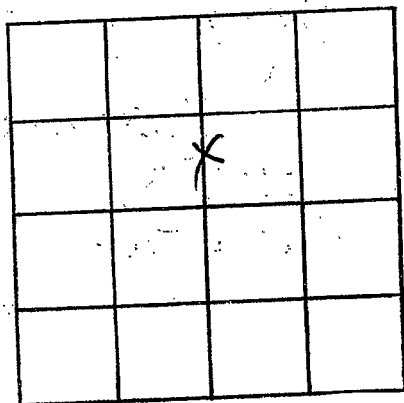

SECTION W  
Please indicate well location X.

ADDITIONAL INFORMATION

If more than one screen,  
show locations of each on sketch.