

MARION
K61
1-11-74

MISSISSIPPI
BOARD OF WATER COMMISSIONERS
416 North State Street
Jackson, Mississippi 39201

CODED

WATER WELL DRILLERS LOG

1-11-1974 date well completed
GRINER - GINN firm name
Marion county well located

LANDOWNER:
Lester Bedwell
Rt. 2
Jovonath
(mailing address) Miss

description of formations encountered	from	to
Top Soil	0	2
Clay	2	8
Gravel	8	9 1/2
Chalk	9 1/2	15 1/2
Sand	15 1/2	25 1/2

WELL LOCATION:
sec 31 T 30 S R 13 E
14 miles SW of Falmouth
(distance) (direction) (nearest town)

WELL PURPOSE: Home
(home, irrigation, municipal, industrial)

- WELL COMPLETION DATA:
- (1) diameter (inches) 4"
 - (2) total depth (feet) 250
 - (3) static water level (feet) 105 below top of ground.
 - (4) casing plastic, 240 (material) (depth)
4" (size) If telescope see back.
 - (5) screen 10' 240 (length) (depth to top)
4" (size) plastic (material)
 - (6) pump 3/4 10 (HP) (yield gpm)
elec. (type power)
 - (7) electric log NO (yes or no)
NO (organization running log)
 - (8) how well bottom plugged
B.W. Valve


CODED

DRILLERS REMARKS:

RECORDED
MAY 28 1974
MISS. Bd. of WATER COMMISSIONERS

If well telescopes please sketch and show depths.

GROUND LEVEL

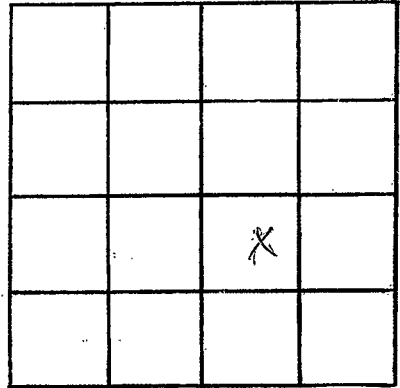

SECTION 31

Please indicate well location X.

ADDITIONAL INFORMATION

If more than one screen, show locations of each on sketch.