

MARION
K62
5174

MISSISSIPPI
BOARD OF WATER COMMISSIONERS CODED
416 North State Street
Jackson, Mississippi 39201

WATER WELL DRILLERS LOG

May 1974 E.B. Sherrard (Marion)
date well completed firm name county well located

LANDOWNER:
Albie W. Turnipseed
Rt. 2 - Forwath MS.
(mailing address)


description of formations encountered	from	to
LOOSE BED		
SAND	0	40
GRAVEL STAKS	40	80
SAND & GRAVEL	80	122

WELL LOCATION:
sec. 23 T. 3 N. R. 13 E.
2 miles S Forwath
(distance) (direction) (nearest town)

WELL PURPOSE:
~~home~~ irrigation, municipal, industrial

- WELL COMPLETION DATA:
- (1) diameter (inches) 9"
 - (2) total depth (feet) 122'
 - (3) static water level (feet) 78' ^{below} top of ground.
 - (4) casing pl. (material) 117' (depth)
2" (size) If telescope see back.
 - (5) screen 5' (length) (depth to top)
2" (size) pl. (material)
 - (6) pump 1 (HP) 7 (yield gpm)
E (type power)
 - (7) electric log (yes or no)
 - (8) how well bottom plugged BWV

CODED

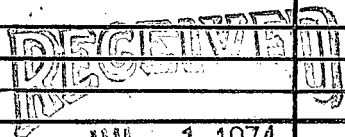


MAY 1 1974

DRILLERS REMARKS:

If well telescopes please sketch and show depths.

GROUND LEVEL

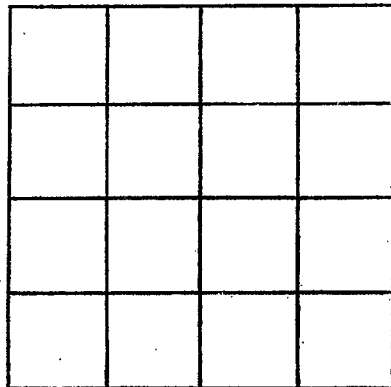

SECTION _____

Please indicate well location X.

ADDITIONAL INFORMATION

If more than one screen, show locations of each on sketch.