

MARION  
K 64  
4/74

MISSISSIPPI  
BOARD OF WATER COMMISSIONERS CODED  
416 North State Street  
Jackson, Mississippi 39201

WATER WELL DRILLERS LOG

April 1974 E.B. Sheppard Marion  
date well completed firm name county well located

LANDOWNER:	description of formations encountered	from	to
(mailing address)			
William Jefferson Rt. 1 - Kakoma, Miss.	SANDY RED CLAY GRAVEL SAND + GRAVEL	0	58 103
WELL LOCATION:			
sec. 19 T 3 N R 13 E S W 3 1/2 miles W of Foxworth (distance) (direction) (nearest town)			
WELL PURPOSE: (home, irrigation, municipal, industrial)			
WELL COMPLETION DATA:			
(1) diameter (inches) 2"			
(2) total depth (feet) 103'			
(3) static water level (feet) 70' below top of ground.			
(4) casing (material) pl. (depth) 98'			
2" (size) if telescope see back.			
(5) screen (length) 5' (depth to top)			
3" (size) pl. (material)			
(6) pump (HP) 1 (yield gpm) 7			
E (type power)			
(7) electric log (yes or no)			
(organization running log)			
(8) how well bottom plugged B.W.V.			
DRILLERS REMARKS:			


CODED

DECEMBER 1 1974

MISS. BD. OF WATER COMMISSIONERS

If well telescopes please sketch and show depths.

GROUND LEVEL

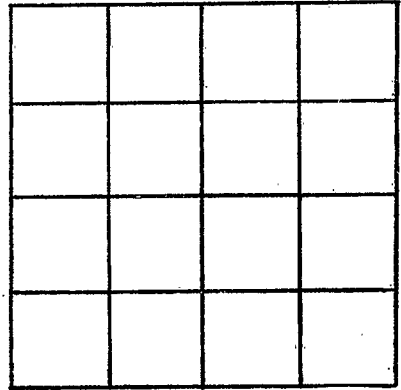

SECTION \_\_\_\_\_

Please indicate well location X.

ADDITIONAL INFORMATION

If more than one screen, show locations of each on sketch.