

MARION
K65
2/74

MISSISSIPPI
BOARD OF WATER COMMISSIONERS
416 North State Street
Jackson, Mississippi 39201

CODED

WATER WELL DRILLERS LOG

Feb. 1974 E.B. Sheppard Marion
date well completed firm name county well located

LANDOWNER:
Kevin Thomas
Foyworth, Miss.
(mailing address)

description of formations encountered	from	to
BED SANDY CLAY	0	70'
SAND + GR.	70'	100'

WELL LOCATION:
sec. 15 T 30 N R 13 E
S W
1/2 miles W Foyworth
(distance) (direction) (nearest town)

CODED

WELL PURPOSE:
(home, irrigation, municipal, industrial)

WELL COMPLETION DATA:

(1) diameter (inches) 2"

(2) total depth (feet) 100'

(3) static water level (feet) 68' below above top of ground.

(4) casing pl. 95' (material) (depth)
2" (size) If telescope see back.

(5) screen 5' (length) (depth to top)
2" (size) pl. (material)

(6) pump 1 (HP) 7 (yield gpm)
E (type power)

(7) electric log (yes or no)

(organization running log)


(8) how well bottom plugged B/W

DRILLERS REMARKS:

REGISTERED
MAY 1 1974
MISS. BD. OF WATER COMMISSIONERS

If well telescopes please sketch and show depths.

GROUND LEVEL

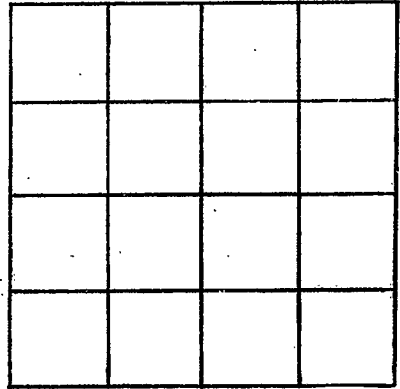

SECTION _____

Please indicate well location X.

ADDITIONAL INFORMATION

If more than one screen, show locations of each on sketch.