

MARION
K66
9-16-74

MISSISSIPPI
BOARD OF WATER COMMISSIONERS
416 North State Street
Jackson, Mississippi 39201

WATER WELL DRILLERS LOG

CODED

9-16
date well completed


1974 Criver - Cinn
firm name

Marion
county well located

LANDOWNER:	description of fomations encountered	from	to
Pleasant Hill Penicostal			
Rt. 2 Foxworth	Clay	1	26
(mailing address) MISS.	Clay + gravel	26	42
	Chalk	42	60
	Sand	60	80
WELL LOCATION:			
sec. 21 T 3 N R 13 E			
3 miles SW of Columbus			
(distance) (direction) (nearest town)			
WELL PURPOSE: <u>Church</u>			
(home, irrigation, municipal, industrial)			
WELL COMPLETION DATA:			
(1) diameter (inches) <u>2"</u>	CODED		
(2) total depth (feet) <u>80</u>			
(3) static water level (feet) <u>40</u> below top of ground.			
(4) casing <u>plastic</u> , <u>70</u> (material) (depth)			
<u>2"</u> (size) if telescope see back.			
(5) screen <u>10'</u> , <u>70</u> (length) (depth to top)			
<u>2"</u> , <u>plastic</u> (size) (material)			
(6) pump <u>1</u> (HP) (yield gpm)			
<u>elec.</u> (type power)	RECEIVED DECEMBER 26 1974		
(7) electric log <u>NO</u> (yes or no)			
<u>NO</u> (organization running log)			
(8) how well bottom plugged <u>B.W. Cinn</u>			
DRILLERS REMARKS:			
MISS. BD. OF WATER COMMISSIONERS			

If well telescopes please sketch and show depths.

GROUND LEVEL

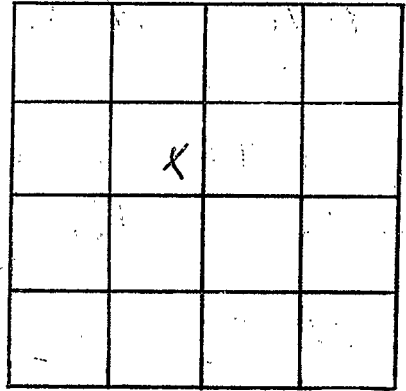

SECTION 21

Please indicate well location X.

ADDITIONAL INFORMATION

If more than one screen,
show locations of each on sketch.