

Marion
K 67
9/75

MISSISSIPPI
BOARD OF WATER COMMISSIONERS
416 North State Street
Jackson, Mississippi 39201

CODED

WATER WELL DRILLERS LOG

April 1975 E.B. Sheppard Marion
date well completed firm name county well located

LANDOWNER:
Shirley Wilson
Fogworth, Ms.
(mailing address)

description of formations encountered	from	to
LOOSE RED SAND		
RED CLAY		
STREAKS	0	70
GR. SAND	70	102

WELL LOCATION:
sec 22 T 3 N R 13 E
S W
1 miles S Fogworth
(distance) (direction) (nearest town)

WELL PURPOSE:
(home) irrigation, municipal, industrial


- WELL COMPLETION DATA:
- (1) diameter (inches) 2"
 - (2) total depth (feet) 102'
 - (3) static water level (feet) 60' below above top of ground.
 - (4) casing pl 97' (material) (depth)
2" (size) If telescope see back.
 - (5) screen 5' (length) (depth to top)
2" (size) pl (material)
 - (6) pump 1 (HP) 7 (yield gpm)
E (type power)
 - (7) electric log (yes or no)
 - (organization running log)
 - (8) how well bottom plugged BWV

RECEIVED
MAY - 8 1975

DRILLERS REMARKS:

If well telescopes please sketch and show depths.

GROUND LEVEL

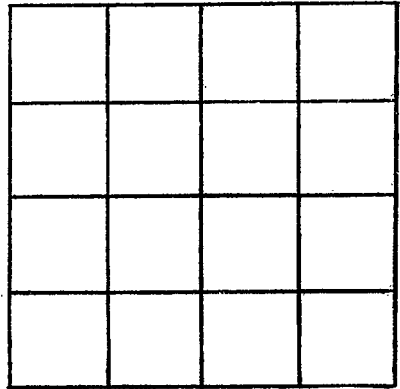

SECTION _____

Please indicate well location X.

ADDITIONAL INFORMATION

If more than one screen,
show locations of each on sketch.