

Marion
K68
1/75

MISSISSIPPI
BOARD OF WATER COMMISSIONERS
416 North State Street
Jackson, Mississippi 39201

CODED

WATER WELL DRILLERS LOG

JAN. 19 25 E. B. Sheppard Marion
date well completed firm name county well located


LANDOWNER:	description of formations encountered	from	to
Frank Leston	RED CLAY		
Rt. 1 - Foxworthy, Ms. (mailing address)	SANDY PEA GR + SAND	2 75	75 90
WELL LOCATION:			
sec 31 T 3 N R 13 E S W 4 miles SW of Foxworthy (distance) (direction) (nearest town)			
WELL PURPOSE: (home, irrigation, municipal, industrial)			
WELL COMPLETION DATA:			
(1) diameter (inches) 2"			
(2) total depth (feet) 90'			
(3) static water level (feet) 70' below above top of ground.			
(4) casing pl. 85' (material) (depth) 2" if telescope see back. (size)			
(5) screen 5' (length) (depth to top) 2" pl. (size) (material)			
(6) pump 3/4 7 (HP) (yield gpm) e (type power)			
(7) electric log (yes or no)			
(organization running log)			
(8) how well bottom plugged BNV			
DRILLERS REMARKS:			

RECEIVED

MAY - 8 1975

If well telescopes please
sketch and show depths.

GROUND LEVEL

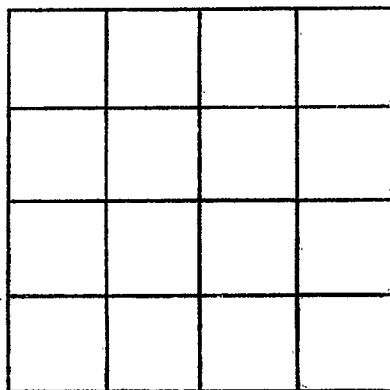

SECTION _____

Please indicate well location X.

ADDITIONAL INFORMATION

If more than one screen,
show locations of each on sketch.