

MARION
K 71
10-3-15

MISSISSIPPI
BOARD OF WATER COMMISSIONERS
416 North State Street
Jackson, Mississippi 39201

WATER WELL DRILLERS LOG

CODED

10-3
date well completed

1975 General - Gunn
firm name

MARION
county well located

LANDOWNER:
Triple R. Ranch

(mailing address)

description of formations encountered	from	to
<u>Top Soil</u>	<u>0</u>	<u>1</u>
<u>Clay</u>	<u>1</u>	<u>16</u>
<u>Chalk</u>	<u>16</u>	<u>425</u>
<u>Sand</u>	<u>425</u>	<u>500</u>

WELL LOCATION:
sec. 23 T. 3 N. R. X 13E
3 miles S of Forrest
(distance) (direction) (nearest town)

WELL PURPOSE: Cash Pond
(home, irrigation, municipal, industrial)

- WELL COMPLETION DATA:
- (1) diameter (inches) 4"
 - (2) total depth (feet) 500 ft
 - (3) static water level (feet) 8 ~~below~~ above top of ground.
 - (4) casing PVC, 480
(material) (depth)
(size) if telescope see back.
 - (5) screen 20, 480
(length) (depth to top)
4", 55
(size) (material)
 - (6) pump None, 70 gpm
(HP) (yield gpm)
(type power)
 - (7) electric log
(yes or no)
(organization running log)
 - (8) how well bottom plugged 12W Valve

DRILLERS REMARKS:

CODED


DEPT. OF WATER COMM.

DEC 22 1975

MISS. BOARD OF WATER COMM.

If well telescopes please sketch and show depths.

GROUND LEVEL

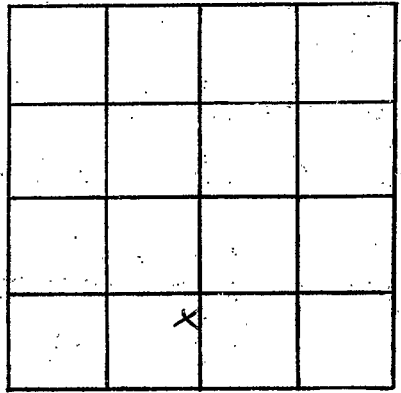

SECTION 23

Please indicate well location X.

ADDITIONAL INFORMATION

Lined area for additional information.

If more than one screen, show locations of each on sketch.