

MARION
 K 73
 10/180
 E Log #106
 Oct 1980

MISSISSIPPI
 BOARD OF WATER COMMISSIONERS
 416 North State Street
 Jackson, Mississippi 39201

CODED

WATER WELL DRILLERS LOG

PRINER DRILLING SERVICE MARION

date well completed

firm name

county well located

LANDOWNER: WEST MARION

description of formations encountered

from to

WATER ASSOC. Well
 No. 1
 (mailing address)

Top soil	0	3
Red SANDY CLAY	3	20
SAND & GRAVEL	20	300
CLAY	300	322
SAND	322	520
CLAY	520	722
SAND + PEA GRAVEL	722	838
CLAY	838	1010
SANDY CLAY	1010	1050
CLAY	1050	1150
SAND	1150	1168
SANDY CLAY	1168	1174
SAND	1174	1226
CLAY & Rocks	1226	1450
SAND with 2-1/4" sticks	1450	1522
CLAY & Rocks	1522	1610

WELL LOCATION: NWA SW 1/4 NE 1/4
 sec. 28 T. 3 N. R. 13 E

miles (distance) of (direction) of (nearest town)

WELL PURPOSE: Water W. & Irr.
 (home, irrigation, municipal, industrial)

WELL COMPLETION DATA:

(1) diameter (inches) 10 3/4
 (2) total depth (feet) 1222
 (3) static water level (feet) 2470.8 below top of ground.

(4) casing Steel 1172'
 (material) (depth)
10 3/4" If telescope see back.
 (size)

(5) screen 40' 1182'
 (length) (depth to top)
6 304 S.S. (008)
 (size) (material)

(6) pump 40 250
 (HP) (yield gpm)
Elect.
 (type power)

(7) electric log Yes.
 (yes or no)
MISS. Geol. Survey
 (organization running log)

(8) how well bottom plugged BLACK
WASH PLUG

DRILLERS REMARKS:

DEPT. OF NATURAL RESOURCES
 BUREAU OF LAND & WATER RESOURCES


OCT 31 1980

RECEIVED

2

If well telescopes please sketch and show depths.

GROUND LEVEL

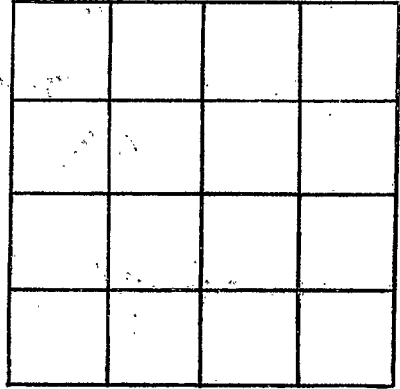

SECTION _____

Please indicate well location X.

ADDITIONAL INFORMATION

A series of horizontal lines for providing additional information, located to the right of the 'ADDITIONAL INFORMATION' header.

If more than one screen, show locations of each on sketch.