

MISSISSIPPI DEPARTMENT OF NATURAL RESOURCES

Bureau of Land and Water Resources

Southport Mall

P.O. Box 10631

Jackson, Mississippi 39209

WATER WELL DRILLERS LOG

CODED

MARION  
K 74  
12-22-80

Gyner Drilling Service, Inc. Marion

date well completed

firm name

county well located

LANDOWNER:

Ornet Production  
1515 Capital Towers  
Jackson, MS 39205  
(mailing address)

description of formations encountered

from

to

chalk	0	15
sand + gravel	15	70
chalk	70	126
sand	126	147
chalk rock	147	399
sand	399	462
sand		

WELL LOCATION: 2061 S + 6471 W

NO. 23-3 (N) R. 13 (E) of  
Robert Foxworth  
23-8 (Foxworth) miles of (distance) (direction) of (nearest town)

WELL PURPOSE: oil field  
(home, irrigation, municipal, industrial)

WELL COMPLETION DATA:

- (1) diameter (inches) 4"
- (2) total depth (feet) 462'
- (3) static water level (feet) flow above top of ground.
- (4) casing steel 462'  
(material) (depth)  
4"  
(size) if telescope see back.
- (5) screen 42', 420'  
(length) (depth to top)  
4" perforated  
(size) (material)
- (6) pump 20  
(HP) (yield gpm)  
ac  
(type power)
- (7) electric log \_\_\_\_\_  
(yes or no)

(organization running log)

- (8) how well bottom plugged orange  
peel

DRILLERS REMARKS:


DEPT. OF NATURAL RESOURCES  
BUREAU OF LAND & WATER RESOURCES

JAN 19 1981

RECEIVED

If well telescopes please  
sketch and show depths.

GROUND LEVEL

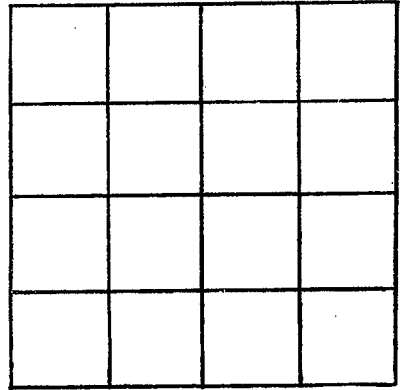

SECTION \_\_\_\_\_

Please indicate well location X.

ADDITIONAL INFORMATION

If more than one screen,  
show locations of each on sketch.