State W	ell Report For Office Use Only:	
Mania Part 1-1	Driller's Log	
	nt of Environmental Quality Aquifer:	
Permit #: 0-586 Office of Land a	nd Water Resources Box 2309 Well #:K 10 2	
	L. S. Elevation:	
11.70-17 (601)	961-5210	
4	1- 5228 (fax) E-log #:	
State Law requires that this report be prepared by the license holder responsible for the work and filed with the		
The state of the s		
Information on Well Owner		
(Landowner if borchole is not for a water well)	Latitude 31. 11 . 385 Longitude: 19 52. 344	
Ordener Name_ Kirk Smith	Latitude <u>131° /1 '355</u> Longitude <u>131° /1 '355</u> Longitude <u>50</u>	
Mailing Address 16 Poular Ly	Method of Lat/Long (circle one). Conventional cartofy	
Forwarth Ms	USGS quad, Hand-held GPS, Survey-grade GPS	
39483	NE 14 NW/4 Sec 34 Twn 26 Rng 13E 31	
City State Zip Code	Distance Direction Nearest Town 	
Telephone No. ()		
Well / Bor	shole Data	
	Val 1	
Date drilling started: 11-20-12 Date drilling completed: 11-20-12 Hole depth: 86 Hole diameter: 7 Location of the source of any surface water used for drilling: There is the source of any surface water used for drilling and development: 5 heavy 2 11-		
Leastion of the source of any surface water used for drilling:	reck charles 2/1-	
Method of dosing and volume of Chlorine used in drilling and deve	lopment: Shack 2.4.1.	
Logs run (circle all applicable): No log run Electric Gamma Ray Density Sonic Neutron Other:		
Aligner of amonization running log(S):		
Name of organization funding $\log(0)$.		
Seismic Survey Other (describe) If drilling is not related to water well construction, skip the remainder of this block		
If drilling is not related to water weat construction and the second sec		
Purpose of Well (check one): Home Industrial Public Supply Irrigation Fish Culture Other:		
If a flowing well, method of flow regulation: Valve Other (describe)		
Static Water Level: feet above of below (circle one) land surface Date measured:		
Method of Measurement (circle one) steel tape electric tape air line other:		
Well depth: 20 Well grouted to a depth of 10 feet Type of grout (circle one): Neat Cement) Bentonite Mix		
Gring length: 60 feet Casing diameter: 4 inches Type of casing: PUC		
Casing length:		
Screen length: <u>CO</u> rect Screen and the From <u>CO</u> fcet to <u>80</u> feet		
Screen slot size:		
Type of completion (circle an applicable): Other (describe):		
Top of lap pipe or reduction in casing:feet. If telescoped or more than one screen, describe on next page Form: OLWR-SWR-1A (04/08		
Form. Of WK-SW(F)/K (6)/CF		

i .

2 . e

RECEIVED

JAN 1 4 2013

BY: OLWR

The sketch below only required for water wells

If well telescopes, show depths on sketch. Ground Level......

 Description of Formations Encountered
 From (depth)
 To (depth)


 Ground Level
 2
 15

 Sec.l
 15
 40

 Pau Phase
 40
 30

Description of formations encountered must be provided for all wells and boreholes, unless specifically exempted by regulations

If more than one screen, show location of each on sketch

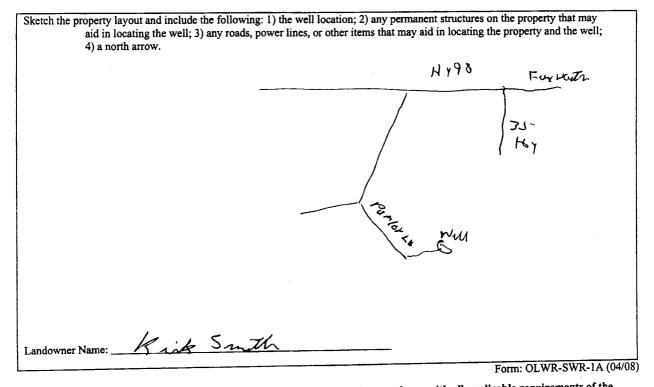

I certify that the well/borehole was drilled, constructed, and completed in accordance with all applicable requirements of the Mississippi Department of Environmental Quality and the Mississippi Department of Health regulations, if applicable, and state

TAMES WELLS 0.586

Print Name of Responsible Licensee and License No.

Date

amos Walls

Signature of Licensee

RECEIVED

JAN 1 4 2013

BY: OLWR

STATE WELL REPORT		
County: Marian Premo Installer's	art 2 S Completion Report t of Environmental Quality Aquifer.	Use Only:
Driller: <u>JAMES WELLS</u> Iackson, N (601)	and Water Resources	1
Date completed:		
installation of pump. Well Owner Information	Well Location	
Owner Name: Kick Smith	Latitude: 431.11-355 Longitude: W 08	
Mailing Address: 46 Paulon Lh	Method of Lat/Long (circle one): Conventional S	
Freywarth ms	USGS quad, Hand-held GPS, Survey	
<u>39483</u> City State Zip Code	NE 14 NW 14 Sec 34 Twn 247 Distance Direction Nearest Town	Rng 13k
City	Distance Direction Nearest Town	
Telephone No. ()		
Pump Type Circle onc	Power Type Circle one	
Air Lift Jet Submersible	Diesel Engine Gasoline Engine	Natural Gas
Bucket Piston Turbine	Electric Motor Hand	Tractor PTO
Centrifugal Rotary Flowing Well	Windmill Other (specify): Horse Power Rating of Motor: /	
Other (specify):		eet
Date Pump Installed:	Setting Depth:	
Rated Pump Capacity:/5 Gallons Per Minute	Number of Stages:	
	Method of Measuring Water Le	vel
Pump Test Data	Circle one	
Date Well Tested: //~20-/2	All Line Lacone menergener	Steel Tape
Static Water Level (A): <u>30</u> Feet Below Land Surface Pumping Water Level (B): <u>570</u> Feet Below Land Surface	Other (specify):	
Drawdown [(B) – (A)]: Feet Below Land Surface	For flowing well, measured shut in head:	feet
Test Pumping Rate: [5] Gallons Per Minute	Well yielded / GPM with a dr	
Duration of Pump Test (minimum 4 hours):hours	2030 the feet after4 hor	urs of pumping
	- 1	
I HEREBY CERTIFY that the above statements are true to the best $JAMES$ $WELLS$ $O-586$	s of my knowledge. Comes Well Signature of Pump Installer	/ ~
Print Name of Pump Installer and License No. (if applicable)	Signature of Fundy materies	

¥

.

RECEIVED JAN 1 4 2013

BY: OLWR