

Marion
 K 2001
 8/75

MISSISSIPPI
 BOARD OF WATER COMMISSIONERS
 416 North State Street
 Jackson, Mississippi 39201

WATER WELL DRILLERS LOG

August 25 E. B. Sheward Marion
 date well completed firm name county well located

LANDOWNER:	description of formations encountered	from	to
Kenneth Alford	RED CLAY	0	40'
Rt. 3 - Foxworth, Ms.	SANDY CLAY	40	70'
(mailing address)	DEA GR. + SAND	70	95'

WELL LOCATION:
 sec 22 T 3 N R 13 E 13V
 1 miles S Foxworth
 (distance) (direction) (nearest town)

WELL PURPOSE:
 (home, irrigation, municipal, industrial)


- WELL COMPLETION DATA:
- (1) diameter (inches) 2"
 - (2) total depth (feet) 95'
 - (3) static water level (feet) 70' ^{below} above top of ground.
 - (4) casing pl 90' (material) (depth)
 2" (size) if telescope see back.
 - (5) screen 5' (length) (depth to top)
 2" (size) pl (material)
 - (6) pump 1 1/2 (HP) 7 (yield gpm)
 E (type power)
 - (7) electric log (yes or no)
 - (8) how well bottom plugged BWN

DRILLERS REMARKS:

RECEIVED
 DEC - 5 1975
 MISS. BD. OF WATER COMMISSIONERS

If well telescopes please
sketch and show depths.

GROUND LEVEL

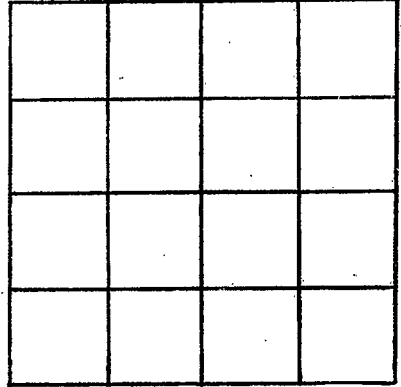

SECTION _____

Please indicate well location X.

ADDITIONAL INFORMATION

If more than one screen,
show locations of each on sketch.