

Marion
K 2002
6-75

MISSISSIPPI
BOARD OF WATER COMMISSIONERS
416 North State Street
Jackson, Mississippi 39201


WATER WELL DRILLERS LOG

June 1975 E.B. Sherrard Marion
date well completed firm name county well located

LANDOWNER:	description of formations encountered	from	to
Brady Lewis Foyworth, MS. (mailing address)	RED SANDY CLAY SAND & PEA GR.	0	50' 90'
WELL LOCATION: sec. 15 T. 30 N. R. 13 E. 13V S W 1/4 miles SW Foyworth (distance) (direction) (nearest town)			
WELL PURPOSE: (home, irrigation, municipal, industrial)			
WELL COMPLETION DATA:			
(1) diameter (inches) 2"			
(2) total depth (feet) 90'			
(3) static water level (feet) 60 ^{below} above top of ground.			
(4) casing <u>pl.</u> <u>85'</u> (material) (depth) 2" (size) If telescope see back.			
(5) screen <u>5'</u> <u>pl</u> (length) (depth to top) 2" (size) (material)			
(6) pump <u>1</u> <u>7</u> (HP) (yield gpm) <u>E</u> (type power)			
(7) electric log <u>(yes or no)</u>			
(organization running log)			
(8) how well bottom plugged <u>BWV</u>			
DRILLERS REMARKS:			
RECEIVED DEC - 5 1975 MISS. BD. OF WATER COM.			

If well telescopes please sketch and show depths.

GROUND LEVEL

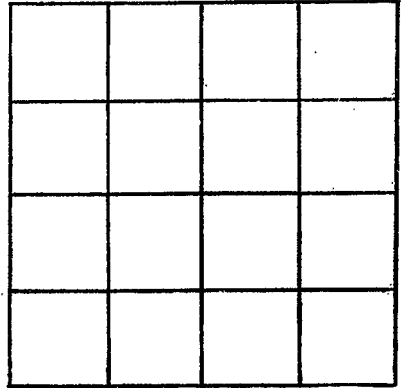

SECTION _____

Please indicate well location X.

ADDITIONAL INFORMATION

If more than one screen,
show locations of each on sketch.