

MARION
K 2004
1-6-76

MISSISSIPPI
 BOARD OF WATER COMMISSIONERS
 416 North State Street
 Jackson, Mississippi 39201

WATER WELL DRILLERS LOG

1-6-76 13V Criner-Criner Marion
 date well completed firm name county well located


LANDOWNER:	description of formations encountered	from	to
<u>Harry Terrell</u>	<u>Top Soil</u>	<u>0</u>	<u>3</u>
<u>Rt 2 Foxworth, Miss.</u> (mailing address)	<u>Loam</u>	<u>3</u>	<u>60</u>
WELL LOCATION:	<u>Gravel</u>	<u>60</u>	<u>79</u>
sec <u>30</u> T <u>3</u> N <u>7</u> E	<u>Chalk</u>	<u>79</u>	<u>108</u>
R <u>22</u>	<u>Sand & Gravel</u>	<u>108</u>	<u>149</u>
<u>3</u> miles <u>NW</u> of <u>Foxworth</u>	<u>Loam</u>	<u>149</u>	<u>200</u>
(distance) (direction) (nearest town)			
WELL PURPOSE: <u>Home</u> (home, irrigation, municipal, industrial)			
WELL COMPLETION DATA:			
(1) diameter (inches) <u>2"</u>			
(2) total depth (feet) <u>200</u>			
(3) static water level (feet) <u>100</u> above top of ground.			
(4) casing <u>PVC</u> , <u>190</u> (material) (depth)			
<u>2"</u> if telescope see back. (size)			
(5) screen <u>10'</u> , <u>190</u> (length) (depth to top)			
<u>2"</u> , <u>PVC</u> (size) (material)			
(6) pump <u>1 1/2</u> , <u>8</u> (HP) (yield gpm)			
<u>elec</u> (type power)			
(7) electric log <u>NO</u> (yes or no)			
(organization running log)			
(8) how well bottom plugged <u>B.W. valve</u>			
DRILLERS REMARKS:			

RECEIVED
 RECEIVED

MAR 29 1976

If well telescopes please sketch and show depths.

GROUND LEVEL

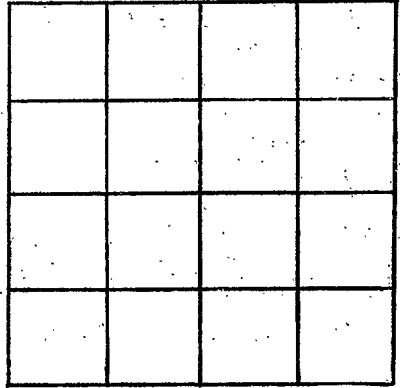

SECTION _____

Please indicate well location X.

ADDITIONAL INFORMATION

If more than one screen, show locations of each on sketch.