

**MISSISSIPPI
BOARD OF WATER COMMISSIONERS**
416 North State Street
Jackson, Mississippi 39201


MARION
R 2005
1-8-76

13V

WATER WELL DRILLERS LOG

1/8/76 19 Hollinger Plumb. + Water Well MARION
date well completed firm name county well located


LANDOWNER: <u>Sarada Disha</u> <u>Rt 3</u>	description of formations encountered	from	to
<u>Foxworth, Miss. 39483</u> (mailing address)	<u>Clay sand</u> <u>sand + GRAVEL</u>	<u>0</u> <u>38</u>	<u>38</u> <u>80</u>
WELL LOCATION: sec. <u>16</u> T. <u>3</u> N. R. <u>14</u> E. <u>1 1/2</u> miles <u>W.</u> of <u>Foxworth</u> (distance) (direction) (nearest town)			
WELL PURPOSE: <u>Home</u> (home, irrigation, municipal, industrial)			
WELL COMPLETION DATA:			
(1) diameter (inches) <u>2"</u>			
(2) total depth (feet) <u>80 ft</u>			
(3) static water level (feet) <u>30</u> <u>below</u> above top of ground.			
(4) casing <u>pvc</u> (material) (depth) <u>No</u> (size) if telescope see back.			
(5) screen <u>5 ft</u> <u>75</u> (length) (depth to top)			
<u>2"</u> (size) <u>pvc</u> (material)			
(6) pump <u>1/2</u> (HP) <u>7</u> (yield gpm)			
<u>elect.</u> (type power)			
(7) electric log <u>No</u> (yes or no)			
(organization running log)			
(8) how well bottom plugged <u>sand</u> <u>shark</u>			
DRILLERS REMARKS: <u>good well</u>			

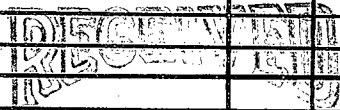

FEB 11 1976

If well telescopes please sketch and show depths.

GROUND LEVEL

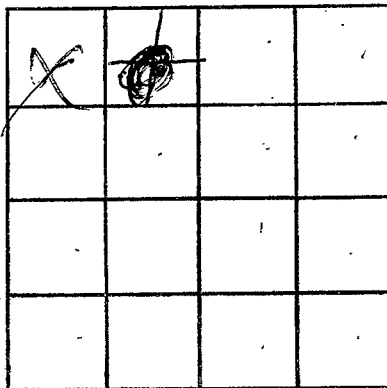

SECTION 16

Please indicate well location X.

ADDITIONAL INFORMATION

If more than one screen, show locations of each on sketch.