

MARION
K 2006
1-16-76

MISSISSIPPI
BOARD OF WATER COMMISSIONERS
 416 North State Street
 Jackson, Mississippi 39201

WATER WELL DRILLERS LOG

1-16-76 19 **76** **Craver - Binn** **MARION**
 date well completed firm name county well located

LANDOWNER:
Houston May
Rt. 3 Foxworth, Miss.
 (mailing address)

WELL LOCATION:
 sec. **9** T. **30N** R. **13E**
~~14E~~
~~2W~~
1/2 miles **W** of **Foxworth**
 (distance) (direction) (nearest town)

WELL PURPOSE: **Home**
 (home, irrigation, municipal, industrial)

- WELL COMPLETION DATA:**
- (1) diameter (inches) **4"**
 - (2) total depth (feet) **210**
 - (3) static water level (feet) **125** below above top of ground.
 - (4) casing **PVC**, **200**,
 (material) (depth)
4" If telescope see back.
 (size)
 - (5) screen **10'**, **200**.
 (length) (depth to top)
4", **PVC**
 (size) (material)
 - (6) pump **3/4**, **12**.
 (HP) (yield gpm)
elec
 (type power)
 - (7) electric log **NO**
 (yes or no)

(organization running log)

(8) how well bottom plugged/
Bit Valve


description of formations encountered	from	to
<i>Red soil</i>	0	1
<i>Clay</i>	1	19
<i>Loam & gravel</i>	19	70
<i>Chalk</i>	70	130
<i>Sand</i>	130	164
<i>Gravel</i>	160	199
<i>Sand</i>	179	210

REGISTERED
INDUSTRIAL
1976
MAR 29 1976

DRILLERS REMARKS:

If well telescopes please sketch and show depths.

GROUND LEVEL

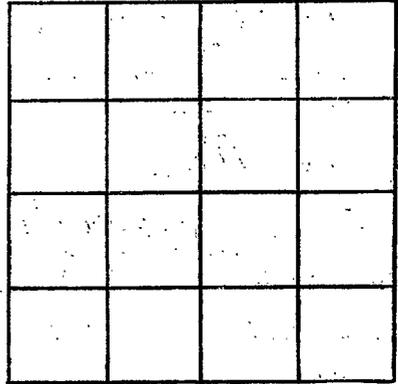

SECTION _____

Please indicate well location X.

ADDITIONAL INFORMATION

If more than one screen, show locations of each on sketch.