


MARION
 K 2007
 2-9-76

MISSISSIPPI
 BOARD OF WATER COMMISSIONERS
 416 North State Street
 Jackson, Mississippi 39201

WATER WELL DRILLERS LOG

2-9 1976 Gruber-Ginn Marion
 date well completed firm name county well located


LANDOWNER:	description of formations encountered	from	to
<u>George Miller</u>	<u>top soil</u>	<u>0</u>	<u>1</u>
<u>Rt. 1 Foxworth, Miss</u> (mailing address)	<u>clay</u>	<u>1</u>	<u>9</u>
WELL LOCATION: sec. <u>8</u> T. <u>4</u> N. R. <u>19</u> E. W. <u>W</u>	<u>sand</u>	<u>9</u>	<u>23</u>
<u>2</u> miles <u>W</u> of <u>Foxworth</u> (distance) (direction) (nearest town)	<u>gravel</u>	<u>29</u>	<u>41</u>
WELL PURPOSE: <u>Home</u> (home, irrigation, municipal, industrial)	<u>chalk</u>	<u>41</u>	<u>94</u>
WELL COMPLETION DATA:	<u>sand & gravel</u>	<u>94</u>	<u>130</u>
(1) diameter (inches) <u>4"</u>	<u>sand</u>	<u>130</u>	<u>130</u>
(2) total depth (feet) <u>190</u>			
(3) static water level (feet) <u>70</u> below top of ground.			
(4) casing <u>PVC</u> <u>180</u> (material) (depth)			
<u>4"</u> If telescope see back. (size)			
(5) screen <u>10'</u> <u>180</u> (length) (depth to top)			
<u>4"</u> <u>PVC</u> (size) (material)			
(6) pump <u>1</u> <u>14</u> (HP) (yield gpm)			
<u>elec.</u> (type power)			
(7) electric log <u>NO</u> (yes or no)			
(organization running log)			
(8) how well bottom plugged <u>B.W. valve</u>			
DRILLERS REMARKS:			

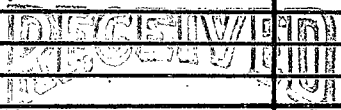

MAR 20 1976

If well telescopes please sketch and show depths.

GROUND LEVEL

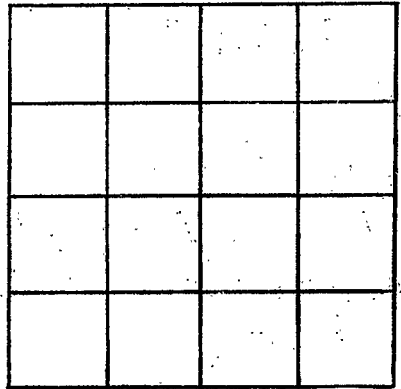

SECTION _____

Please indicate well location X.

ADDITIONAL INFORMATION

If more than one screen, show locations of each on sketch.