

Marion
K 2008
3/76

MISSISSIPPI
BOARD OF WATER COMMISSIONERS
416 North State Street
Jackson, Mississippi 39201

WATER WELL DRILLERS LOG

March 1976 E.B. Sheward, Marion
date well completed firm name county well located

LANDOWNER: Susie Andrews
description of formations encountered: RED SANDY CLAY SAND & GRAVEL
from 0 to 101'
to 101'

Rt. 1 - Kakomo, Miss.
(mailing address)

WELL LOCATION: 13 sec. 19 T 30 N R 12 E S 3 miles W of Hattiesburg
(distance) (direction) (nearest town)

WELL PURPOSE: (home) irrigation, municipal, industrial

- WELL COMPLETION DATA:
- (1) diameter (inches) 2"
 - (2) total depth (feet) 101'
 - (3) static water level (feet) 70' below top of ground.
 - (4) casing pl. 96' (material) (depth)
2" (size) if telescope see back.
 - (5) screen 5' (length) (depth to top)
2" (size) pl. (material)
 - (6) pump 1 (HP) 7 (yfield gpm)
E (type power)
 - (7) electric log (yes or no) (no)
 - (organization running log)
 - (8) how well bottom plugged BNV


RECEIVED
OCT 18 1976

DRILLERS REMARKS:

MISS. BD. OF WATER COMMISSIONERS

If well telescopes please sketch and show depths.

GROUND LEVEL

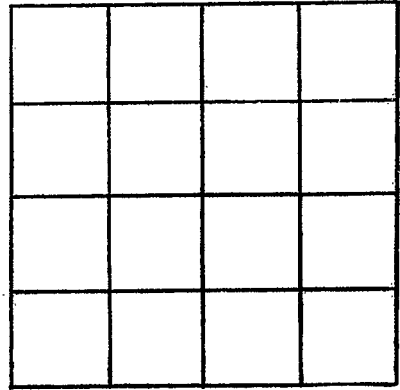

SECTION _____

Please indicate well location X.

ADDITIONAL INFORMATION

If more than one screen, show locations of each on sketch.