

Marion  
 K 2009  
 May 1976

MISSISSIPPI  
 BOARD OF WATER COMMISSIONERS  
 416 North State Street  
 Jackson, Mississippi 39201

WATER WELL DRILLERS LOG

May 1976 <sup>134</sup> E. B. Sherrard Marion  
 date well completed firm name county well located

LANDOWNER:  
 Billy Pennington  
 Foxworth, Ms.  
 (mailing address)

description of formations encountered	from	to
Loose SANDY		
RED CLAY		
GRAVEL	0	80'
REA GR + SAND	80	100'

WELL LOCATION:  
 sec 2 T 30N R 13E  
 S W  
 1 miles W Foxworth  
 (distance) (direction) (nearest town)

WELL PURPOSE:  
 (home) irrigation, municipal, industrial

- WELL COMPLETION DATA:
- (1) diameter (inches) 2"
  - (2) total depth (feet) 100'
  - (3) static water level (feet) 60' <sup>below</sup> <sub>above</sub> top of ground.
  - (4) casing pl. 95'  
 (material) (depth)  
2" If telescope see back.  
 (size)
  - (5) screen 5' pl.  
 (length) (depth to top)  
2" pl.  
 (size) (material)
  - (6) pump 1 7  
 (HP) (yield gpm)  
elec  
 (type power)
  - (7) electric log (yes or no)
  - (8) how well bottom plugged BWV

DRILLERS REMARKS:


RECEIVED

OCT 18 1976

WATER COMMISSION

If well telescopes please sketch and show depths.

GROUND LEVEL

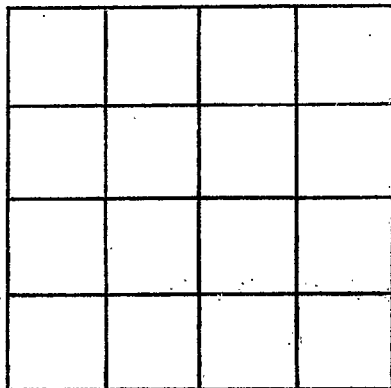

SECTION \_\_\_\_\_

Please indicate well location X.

ADDITIONAL INFORMATION

If more than one screen, show locations of each on sketch.