

Marion
 R 2010
 5/15/76

MISSISSIPPI
 BOARD OF WATER COMMISSIONERS
 416 North State Street
 Jackson, Mississippi 39201

WATER WELL DRILLERS LOG


5/15 1976 Hollinsworth Plant. Water Marion
 date well completed firm name well county well located

| LANDOWNER: Tom Slacum P.O. Box 93 Foxworth, Miss. 39483 (mailing address) | description of formations encountered | from | to |
|---|---------------------------------------|---------------|-----------------|
| WELL LOCATION: sec. 21 T-3 N R-18 E miles of Foxworth (distance) (direction) (nearest town) | Clay clay & sand sand; gravel | 0 20 60 | 20 60 100 |
| WELL PURPOSE: (home, irrigation, municipal, industrial) | | | |
| WELL COMPLETION DATA: (1) diameter (inches) 2" (2) total depth (feet) 100 ft. (3) static water level (feet) 75 below above top of ground. (4) casing pvc 100 ft. (material) (depth) No (size) if telescope see back. (5) screen 5 95 (length) (depth to top) 2 (size) pvc (material) (6) pump 1/2 5 (HP) (yield gpm) elect (type power) (7) electric log N (yes or no) None (organization running log) (8) how well bottom plugged sand SHARK | | | |
| DRILLERS REMARKS: good well | | | |

MISSISSIPPI
 BOARD OF WATER COMMISSIONERS
 APR 22 1976
 JACKSON, MISSISSIPPI

If well telescopes please sketch and show depths.

GROUND LEVEL

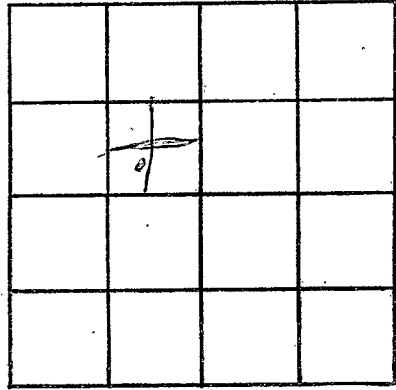

SECTION 21

Please indicate well location X.

ADDITIONAL INFORMATION

If more than one screen,
show locations of each on sketch.