

Marion
 R 2011
 9/15/76

MISSISSIPPI
 BOARD OF WATER COMMISSIONERS
 416 North State Street
 Jackson, Mississippi 39201

13V

WATER WELL DRILLERS LOG

9-15 1976 Briner - Binn Marion
 date well completed firm name county well located

LANDOWNER:
Jessie Bedwell
Rt. 2, Bx. 228 Columbia
 (mailing address) Miss.

WELL LOCATION: 13
 sec. 7 - T. 30 N R. 14 E
7 miles W of Zelma
 (distance) (direction) (nearest town)

WELL PURPOSE:
 (home, irrigation, municipal, industrial)

WELL COMPLETION DATA:

- (1) diameter (inches) 2"
- (2) total depth (feet) 200
- (3) static water level (feet) 145 below above top of ground.
- (4) casing PVC 180
 (material) (depth)
2" if telescope see back.
 (size)
- (5) screen 20' 180
 (length) (depth to top)
2" PVC
 (size) (material)
- (6) pump 2
 (HP) (yield gpm)
elec
 (type power)
- (7) electric log NO
 (yes or no)

(organization running log)

(8) how well bottom plugged
BW, valve

DRILLERS REMARKS:

description of formations encountered	from	to
<u>Top Soil</u>	<u>0</u>	<u>1</u>
<u>Clay</u>	<u>1</u>	<u>4</u>
<u>Gravel</u>	<u>4</u>	<u>17</u>
<u>Sand</u>	<u>17</u>	<u>68</u>
<u>Chalk</u>	<u>68</u>	<u>79</u>
<u>Sand</u>	<u>79</u>	<u>149</u>
<u>Gravel</u>	<u>149</u>	<u>161</u>
<u>Sand</u>	<u>161</u>	<u>200</u>


RECEIVED

FEB 9 1977

MISS. BD. OF WATER COMMISSIONERS

If well telescopes please sketch and show depths.

GROUND LEVEL

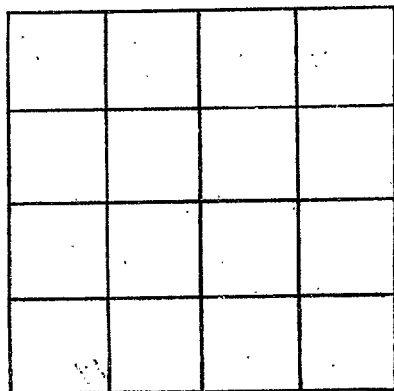

SECTION _____

Please indicate well location X.

ADDITIONAL INFORMATION

If more than one screen, show locations of each on sketch.