

Marion
K 2013
10/30/76

MISSISSIPPI
BOARD OF WATER COMMISSIONERS
416 North State Street
13% Jackson, Mississippi 39201

WATER WELL DRILLERS LOG

10-90 1976 Hollinger Plumb. Marion
date well completed firm name county well located

LANDOWNER: Henry Thomas
RT1 Box 357
Foxworth, Miss
(mailing address)

description of formations encountered	from	to
	Chalk & clay sand & gravel	0 40

WELL LOCATION:
sec. 7 T. 30 N. R. 19 E.
6 miles W of Foxworth
(distance) (direction) (nearest town)

WELL PURPOSE: Home
(home, irrigation, municipal, industrial)

- WELL COMPLETION DATA:
- (1) diameter (inches) 4"
 - (2) total depth (feet) 200
 - (3) static water level (feet) 100 below
top of ground.
 - (4) casing PVC, 200
(material) (depth)

if telescope see back.
(size)
 - (5) screen 10 ft., 190
(length) (depth to top)
4, PVC
(size) (material)
 - (6) pump 1, 14
(HP) (yield gpm)
elect
(type power)
 - (7) electric log (yes or no)

(organization running log)

(8) how well bottom plugged sand
SHARK

DRILLERS REMARKS: good


RECEIVED

NOV 18 1976

MISS. BD. OF WATER COMM

If well telescopes please sketch and show depths.

GROUND LEVEL

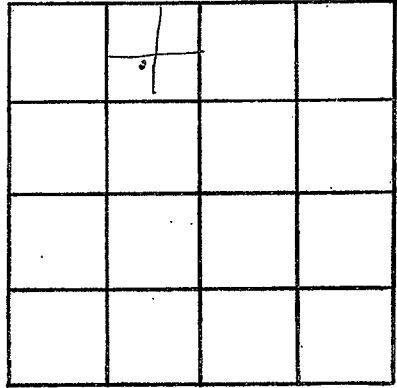

SECTION 7

Please indicate well location X.

ADDITIONAL INFORMATION

If more than one screen,
show locations of each on sketch.