

Marion
K 2015
2/22/77

MISSISSIPPI
BOARD OF WATER COMMISSIONERS
416 North State Street
13V Jackson, Mississippi 39201

WATER WELL DRILLERS LOG

2/22 1977 Hollinsworth Well Service Marion
date well completed firm name county well located

LANDOWNER: <u>Eleanor Holmes</u>	description of formations encountered	from	to
<u>RT 1</u>			
<u>Foxworth Miss</u> (mailing address)	<u>Clay, chalk</u>	<u>0</u>	<u>60</u>
	<u>sand, gravel</u>	<u>60</u>	<u>120</u>
	<u>pea gravel</u>	<u>120</u>	

WELL LOCATION:
sec. 8 T. 30 N. R. 13 E. 13
S. 13
2 miles W of Foxworth
(distance) (direction) (nearest town)

WELL PURPOSE: Home
(home, irrigation, municipal, industrial)

WELL COMPLETION DATA:

- (1) diameter (inches) 4"
- (2) total depth (feet) 200
- (3) static water level (feet) 120 ^{below} above top of ground.
- (4) casing pvc, 190,
(material) (depth)
4 If telescope see back.
(size)
- (5) screen 10, 190
(length) (depth to top)
4, pvc
(size) (material)
- (6) pump 1, 12
(HP) (yield gpm)
elect
(type power)
- (7) electric log _____
(yes or no)

(organization running log)

(8) how well bottom plugged SAND
SHARK

DRILLERS REMARKS: Good well


RECEIVED

APR 26 1977

MISS. BD. OF WATER COMMISSIONERS

If well telescopes please sketch and show depths.

GROUND LEVEL

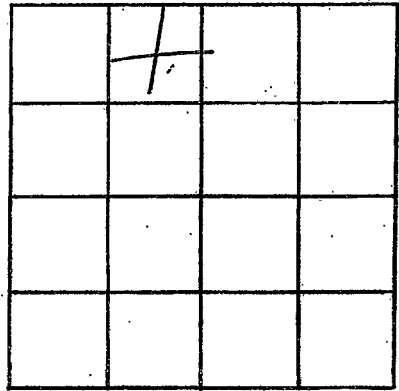

SECTION 8

Please indicate well location X.

ADDITIONAL INFORMATION

If more than one screen, show locations of each on sketch.