

MARION  
K 2016  
3/4/77

MISSISSIPPI  
BOARD OF WATER COMMISSIONERS  
416 North State Street  
Jackson, Mississippi 39201

WATER WELL DRILLERS LOG

3/4 1977 Hollinger Water Well Marion  
date well completed firm name county well located

LANDOWNER: Willie Simmons  
RT 2  
Foxworth, Miss.  
(mailing address)

description of formations encountered	from	to
clay	0	50
sand, gravel	50	100

WELL LOCATION:  
sec 36 T 30 N R 13 E  
S W  
1/4 miles S E of Foxworth  
(distance) (direction) (nearest town)

WELL PURPOSE: Home  
(home, irrigation, municipal, industrial)

WELL COMPLETION DATA:

- (1) diameter (inches) 2"
- (2) total depth (feet) 100
- (3) static water level (feet) 60 below top of ground.
- (4) casing pvc 2"  
(material) (depth)  
(size) If telescope see back.
- (5) screen 5 95  
(length) (depth to top)  
pvc 2" pvc  
(size) (material)
- (6) pump 1 9  
(HP) (yield gpm)  
elect  
(type power)
- (7) electric log (yes or no)

(organization running log)

(8) how well bottom plugged sand  
SHARK


DRILLERS REMARKS: Good Well

RECEIVED  
APR 26 1977

MISS. BD. OF WATER COMMISSIONERS

If well telescopes please sketch and show depths.

GROUND LEVEL

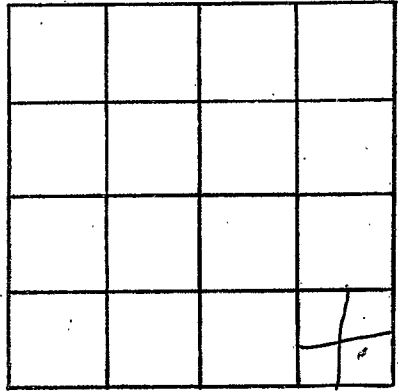

SECTION

36

Please indicate well location X.

ADDITIONAL INFORMATION

If more than one screen,  
show locations of each on sketch.