

Marion
K 2017
3/4/77

MISSISSIPPI
BOARD OF WATER COMMISSIONERS
416 North State Street
Jackson, Mississippi 39201

WATER WELL DRILLERS LOG

3/4 1977 Hollinger Waterwell Marion
date well completed firm name county well located

LANDOWNER: <u>Willie Simmons</u>	description of formations encountered	from	to
<u>Rt 2</u>			
<u>Foxworth Miss. 39482</u> (mailing address)	<u>silt, sand, gravel</u>	<u>0</u>	<u>40</u> <u>40</u> <u>89</u>

WELL LOCATION:
sec 36 T. 3 N. R. 13 E.
2 miles S of Foxworth
(distance) (direction) (nearest town)

WELL PURPOSE: Home
(home, irrigation, municipal, industrial)

WELL COMPLETION DATA:

(1) diameter (inches) 2"

(2) total depth (feet) 87

(3) static water level (feet) 50 below above top of ground.

(4) casing PVC (material) (depth) _____
(size) If telescope see back.

(5) screen 5 82
(length) (depth to top)

2 PVC
(size) (material)

(6) pump 1/2 8
(HP) (yield gpm)

elect
(type power)

(7) electric log _____
(yes or no)

(organization running log)

(8) how well bottom plugged sand
SHARK


DRILLERS REMARKS: good well

RECEIVED
APR 26 1977

MISS. BD. OF WATER COMMISSIONERS

If well telescopes please sketch and show depths.

GROUND LEVEL

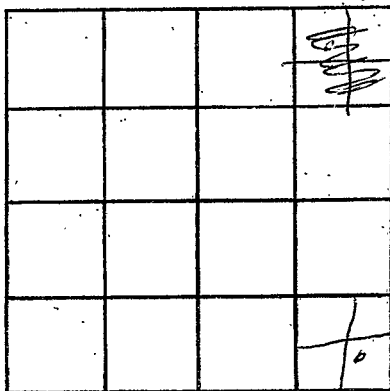

SECTION 36

Please indicate well location X.

ADDITIONAL INFORMATION

If more than one screen,
show locations of each on sketch.