

Marion
K 2018
4/13/77

MISSISSIPPI
BOARD OF WATER COMMISSIONERS
416 North State Street
Jackson, Mississippi 39201

WATER WELL DRILLERS LOG

4/13 date well completed 1977 Hollinger Well firm name Marion county well located

LANDOWNER: Billy F. Holland description of formations encountered from to
 Rt 3 Box 268
 Foxworth, Miss SAND, GRAVEL 0 50
 (mailing address) 50 120

WELL LOCATION:
 sec 33 T 30 N R 13 E
 S SW 1/4 of Foxworth
 (distance) miles (direction) (nearest town)

WELL PURPOSE: Home
 (home, irrigation, municipal, industrial)

WELL COMPLETION DATA:
 (1) diameter (inches) 2"
 (2) total depth (feet) 120
 (3) static water level (feet) 60 below above top of ground.
 (4) casing PVC, 115 (material) (depth) (size) if telescope see back.
 (5) screen 5 (length), 115 (depth to top) 2" (size), PVC (material)
 (6) pump 1 (HP), 10 (yield gpm) elect (type power)
 (7) electric log (yes or no)
 (organization running log)
 (8) how well bottom plugged sand SHARK


DRILLERS REMARKS: Very good

RECEIVED
 APR 26 1977

MISS. BD. OF WATER COMMISSIONERS

If well telescopes please sketch and show depths.

GROUND LEVEL

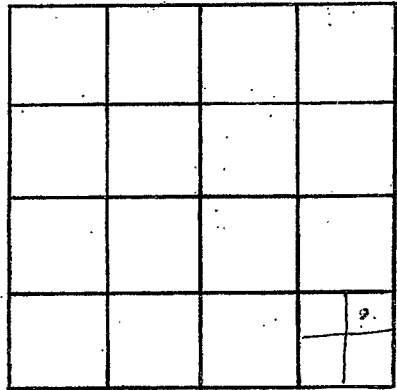

SECTION 33

Please indicate well location X.

ADDITIONAL INFORMATION

If more than one screen,
show locations of each on sketch.