

MARION  
K 2819  
4-14-77

MISSISSIPPI  
BOARD OF WATER COMMISSIONERS  
416 North State Street  
Jackson, Mississippi 39201

(21)

WATER WELL DRILLERS LOG

April 14 1977 Reems Well Co Marion  
date well completed firm name county well located

LANDOWNER:  
Mr. John M. Michels  
P.O. box 204, Foxworth  
(mailing address)

description of formations encountered	from	to
Clay	0	12
Chalk	12	28
Sand & pea gravel	28	102

WELL LOCATION:  
sec. 8 T 3 N R 13 E  
3 miles west of Foxworth  
(distance) (direction) (nearest town)

WELL PURPOSE: house  
(home, irrigation, municipal, industrial)


- WELL COMPLETION DATA:
- (1) diameter (inches) 4"
  - (2) total depth (feet) 102
  - (3) static water level (feet) 40 below top of ground.
  - (4) casing plastic bottom  
(material) (depth)
  - (5) screen 6" 96'  
(length) (depth to top)
  - 4" plastic  
(size) (material)
  - (6) pump 1/2 Sub 10  
(HP) (yield gpm)
  - split  
(type power)
  - (7) electric log no  
(yes or no)
- (organization running log)

(8) how well bottom plugged  
wooden plug  
DRILLERS REMARKS:

RECEIVED  
AUG 1 1977

If well telescopes please:  
sketch and show depths.

GROUND LEVEL

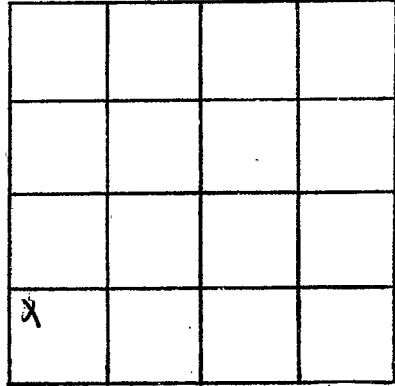

SECTION 8

Please indicate well location X.

ADDITIONAL INFORMATION

If more than one screen,  
show locations of each on sketch.