

Marion
K 2020
6/8/77

MISSISSIPPI
BOARD OF WATER COMMISSIONERS
416 North State Street
Jackson, Mississippi 39201

13V

WATER WELL DRILLERS LOG

6/8 1977 Hollinger Water Well Marion
date well completed film name county well located

LANDOWNER: <u>Bevera Miller</u>	description of formations encountered	from	to
<u>RT 2</u>			
<u>Forworth</u> (mailing address)	<u>Sandy chalk clay</u>	<u>0</u>	<u>15</u>
	<u>Sand, pea gravel</u>	<u>15</u>	<u>47</u>

WELL LOCATION:
sec 36 T 30 (N) R 13
1/4 miles S of Jamestown
(distance) (direction) (nearest town)

WELL PURPOSE: Home
(home, irrigation, municipal, industrial)

WELL COMPLETION DATA:

(1) diameter (inches) 2"

(2) total depth (feet) 47

(3) static water level (feet) 15 below above top of ground.

(4) casing pvc 42
(material) (depth)

(size) if telescope see back.

(5) screen 5 42
(length) (depth to top)

2 pvc
(size) (material)

(6) pump 1/2 7
(HP) (yield gpm)

elect
(type power)

(7) electric log (yes or no)

(organization running log)

(8) how well bottom plugged sand
SHARK


DRILLERS REMARKS: very good

RECEIVED
JUN 25 1977

MISS. Bd. OF WATER COMMISSIONERS

If well telescopes please sketch and show depths.

GROUND LEVEL

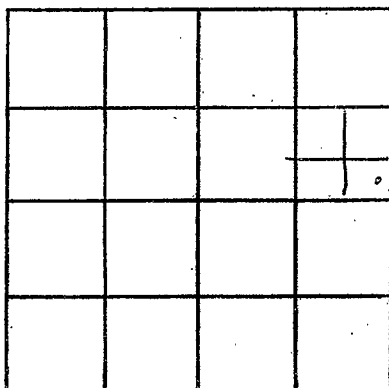

SECTION 36

Please indicate well location X.

ADDITIONAL INFORMATION

If more than one screen, show locations of each on sketch.